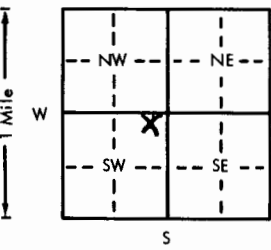
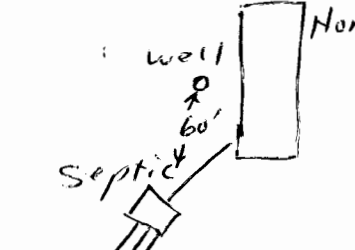


USE TYPEWRITER OR BALL
POINT PEN—PRESS FIRMLY,
PRINT CLEARLY.

WATER WELL RECORD
KSA 82a-1201-1215

Kansas Department of Health and
Environment-Division of Environment
(Water well Contractors)
Topeka, Kansas 66620

County Reno		Fraction NE 1/4 NE 1/4 SW 1/4	Section number 9	Township number T 23 S	Range number R 6 E		
1. Location of well: 607 Town & Country			3. Owner of well: North American Inv.				
Street address of well location if in city: Hutchinson			R.R. or street: 201 White side				
4. Locate with "X" in section below:			City, state, zip code: Hutchinson Kan. 67501				
		Sketch map: 		6. Bore hole dia. 9" in. Completion date 5-29-77 Well depth 35 ft.			
5. Type and color of material		From	To	7. <input type="checkbox"/> Cable tool <input type="checkbox"/> Rotary <input type="checkbox"/> Driven <input checked="" type="checkbox"/> Dug <input type="checkbox"/> Hollow rod <input checked="" type="checkbox"/> Jetted <input type="checkbox"/> Bored <input type="checkbox"/> Reverse rotary			
		Sandy top soil		0	2	8. Use: <input checked="" type="checkbox"/> Domestic <input type="checkbox"/> Public supply <input type="checkbox"/> Industry <input type="checkbox"/> Irrigation <input type="checkbox"/> Air conditioning <input type="checkbox"/> Stock <input type="checkbox"/> Lawn <input type="checkbox"/> Oil field water <input type="checkbox"/> Other	
		brown sandy clay		2	4	9. Casing: Material Plas Height: 6 Above or below Threaded <input type="checkbox"/> Welded <input checked="" type="checkbox"/> Surface 13 in. RMP <input checked="" type="checkbox"/> PVC <input type="checkbox"/> Weight <input type="checkbox"/> lbs./ft.	
		fine gravel		4	8	Dia. 6 in. to 35 ft. depth Wall Thickness: inches or Dia. <input type="checkbox"/> in. to <input type="checkbox"/> ft. depth Gauge No. 175	
		medium gravel		8	35	10. Screen: Manufacturer's name JL Type RMP Dia. 6" Slot/gauze 1/8 hole Length 10' Set between 25 ft. and 35 ft. Gravel pack? NO Size range of material <input type="checkbox"/>	
				11. Static water level: <input type="checkbox"/> mo./day/yr. 10 ft. below land surface Date 5-29-77			
				12. Pumping level below land surfaces: 10 1/2 ft. after 1 hrs. pumping 15 g.p.m. ft. after <input type="checkbox"/> hrs. pumping <input type="checkbox"/> g.p.m. Estimated maximum yield 50 g.p.m.			
				13. Water sample submitted: <input type="checkbox"/> Yes <input checked="" type="checkbox"/> No Date <input type="checkbox"/>			
				14. Well head completion: <input checked="" type="checkbox"/> Pitless adapter 12 inches above grade			
				15. Well grouted? yes With: <input checked="" type="checkbox"/> Neat cement <input type="checkbox"/> Bentonite <input type="checkbox"/> Concrete Depth: From 3 ft. to 11 ft.			
				16. Nearest source of possible contamination: ft. 60 Direction SW Type septic Well disinfected upon completion? <input checked="" type="checkbox"/> Yes <input type="checkbox"/> No			
				17. Pump: Manufacturer's name SFA-RITE Not installed Model number Ser 8 HP 1/2 Volts 230 Length of drop pipe 20 ft. capacity 15 g.p.m. Type: <input checked="" type="checkbox"/> Submersible <input type="checkbox"/> Turbine <input type="checkbox"/> Jet <input type="checkbox"/> Reciprocating <input type="checkbox"/> Centrifugal <input type="checkbox"/> Other			
18. Elevation:		19. Remarks:					
Topography: <input type="checkbox"/> Hill <input type="checkbox"/> Slope <input type="checkbox"/> Upland <input checked="" type="checkbox"/> Valley		20. Water well contractor's certification: This well was drilled under my jurisdiction and this report is true to the best of my knowledge and belief. Price Water Well 193 Business name RR3 Hutchinson License No. 7-20 Address John Davenport Date 7-20 Signed John Davenport Authorized representative					