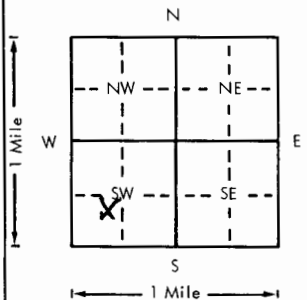
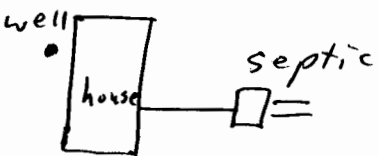


USE TYPEWRITER OR BALL
POINT PEN-PRESS FIRMLY,
PRINT CLEARLY.

WATER WELL RECORD
KSA 82a-1201-1215

Kansas Department of Health and
Environment-Division of Environment
(Water well Contractors)
Topeka, Kansas 66620

1. Location of well:		County Reno	Fraction NE 1/4 SW 1/4 SW 1/4	Section number 9	Township number T 23 S	Range number R 6 E
2. Distance and direction from nearest town or city: Street address of well location if in city:		808 Town & Country Hutchinson		3. Owner of well: R.R. or street: City, state, zip code:		
4. Locate with "X" in section below:		Sketch map:		6. Bore hole dia. 7 in. Completion date 10-3-77 Well depth 35 ft.		
				7. <input type="checkbox"/> Cable tool <input type="checkbox"/> Rotary <input type="checkbox"/> Driven <input checked="" type="checkbox"/> Dug <input type="checkbox"/> Hollow rod <input type="checkbox"/> Jetted <input checked="" type="checkbox"/> Bored <input type="checkbox"/> Reverse rotary		
5. Type and color of material		From		To		8. Use: <input checked="" type="checkbox"/> Domestic <input type="checkbox"/> Public supply <input type="checkbox"/> Industry <input type="checkbox"/> Irrigation <input type="checkbox"/> Air conditioning <input type="checkbox"/> Stock <input type="checkbox"/> Lawn <input type="checkbox"/> Oil field water <input type="checkbox"/> Other
brown sandy soil		0		3		9. Casing: Material Plas Height: Above or below Threaded <input type="checkbox"/> Welded 6 Surface 13 in. RMP <input checked="" type="checkbox"/> PVC <input type="checkbox"/> Weight <input type="checkbox"/> lbs./ft. Dia. 6 in. to 35 ft. depth Wall Thickness: inches or Dia. <input type="checkbox"/> in. to <input type="checkbox"/> ft. depth Gauge No. 175
brown sandy clay		3		6		10. Screen: Manufacturer's name J&L Type RMP Dia. 6" Slot/gauze Vehicle Length 10 Set between 25 ft. and 35 ft. <input type="checkbox"/> ft. and <input type="checkbox"/> ft. Gravel pack? NO Size range of material <input type="checkbox"/>
fine sand		6		8		11. Static water level: <input type="checkbox"/> mo./day/yr. 7 ft. below land surface Date 10-3-77
fine gravel		8		11		12. Pumping level below land surfaces: 9 1/2 ft. after 1 hrs. pumping 15 g.p.m. <input type="checkbox"/> ft. after <input type="checkbox"/> hrs. pumping <input type="checkbox"/> g.p.m. Estimated maximum yield 75 g.p.m.
medium gravel		11		35		13. Water sample submitted: <input type="checkbox"/> mo./day/yr. <input type="checkbox"/> Yes <input checked="" type="checkbox"/> No Date <input type="checkbox"/>
						14. Well head completion: <input checked="" type="checkbox"/> Pitless adapter 12 Inches above grade
						15. Well grouted? yes With: <input checked="" type="checkbox"/> Neat cement <input type="checkbox"/> Bentonite <input type="checkbox"/> Concrete Depth: From 3 ft. to 10 ft.
						16. Nearest source of possible contamination: ft. 60 Direction E Type Septic Well disinfected upon completion? <input checked="" type="checkbox"/> Yes <input type="checkbox"/> No
						17. Pump: Not installed Manufacturer's name STA-RITE Model number SEP 8 HP 1 1/2 Volts 230 Length of drop pipe 25 ft. capacity 12 g.p.m. Type: <input checked="" type="checkbox"/> Submersible <input type="checkbox"/> Turbine <input type="checkbox"/> Jet <input type="checkbox"/> Reciprocating <input type="checkbox"/> Centrifugal <input type="checkbox"/> Other
						20. Water well contractor's certification: This well was drilled under my jurisdiction and this report is true to the best of my knowledge and belief. Price Water Well 193 Business name BR 3 Hutchinson License No. <input type="checkbox"/> Address BR 3 Hutchinson Signed John Davendorf Date 1-24-78 Authorized representative
18. Elevation:		19. Remarks:				
Topography: <input type="checkbox"/> Hill <input type="checkbox"/> Slope <input type="checkbox"/> Upland <input checked="" type="checkbox"/> Valley						