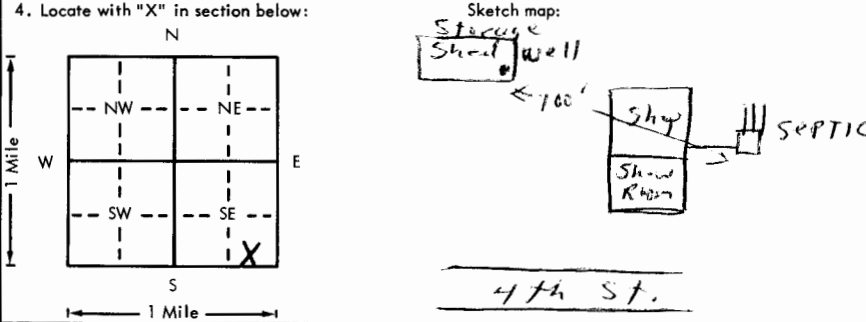


USE TYPEWRITER OR BALL
POINT PEN-PRESS FIRMLY,
PRINT CLEARLY.

WATER WELL RECORD
KSA 82a-1201-1215

Kansas Department of Health and
Environment-Division of Environment
(Water well Contractors)
Topeka, Kansas 66620

1. Location of well:	County <u>Reno</u>	Fraction <u>S 1/4 SE 1/4 SE 1/4</u>	Section number <u>10</u>	Township number <u>T 23 S</u>	Range number <u>R 6 E</u>
2. Distance and direction from nearest town or city: <u>1508 W. 4th</u> Street address of well location if in city: <u>Hutchinson</u>		3. Owner of well: <u>Bornholdt Plantland</u> R.R. or street: <u>1508 W. 4th</u> City, state, zip code: <u>Hutchinson Kan. 67501</u>			
4. Locate with "X" in section below: 		6. Bore hole dia. <u>9</u> in. Completion date <u>1-30-75</u> Well depth <u>28</u> ft.			
5. Type and color of material		7. <input type="checkbox"/> Cable tool <input type="checkbox"/> Rotary <input type="checkbox"/> Driven <input checked="" type="checkbox"/> Dug <input type="checkbox"/> Hollow rod <input type="checkbox"/> Jetted <input checked="" type="checkbox"/> Bored <input type="checkbox"/> Reverse rotary			
		8. Use: <input checked="" type="checkbox"/> Domestic <input type="checkbox"/> Public supply <input type="checkbox"/> Industry <input type="checkbox"/> Irrigation <input type="checkbox"/> Air conditioning <input type="checkbox"/> Stock <input type="checkbox"/> Lawn <input type="checkbox"/> Oil field water <input type="checkbox"/> Other			
		9. Casing: Material <u>Plas</u> Height: <u>Above</u> or below Threaded <input type="checkbox"/> Welded <u>Glue</u> Surface <u>12</u> in. RMP <input checked="" type="checkbox"/> PVC <input type="checkbox"/> Weight <u> </u> lbs./ft. Dia. <u>6</u> in. to <u>28</u> ft. depth Wall Thickness: inches or Dia. <u> </u> in. to <u> </u> ft. depth gauge No. <u>1975</u>			
		10. Screen: Manufacturer's name <u>J&L</u> Type <u>RMP</u> Dia. <u>6"</u> Slot/gauze <u>1/8 hole</u> Length <u>10'</u> Set between <u>18</u> ft. and <u>28</u> ft. <u> </u> ft. and <u> </u> ft. Gravel pack? <u>NO</u> Size range of material <u> </u>			
		11. Static water level: <u>9</u> ft. below land surface Date <u>1-30-75</u> mo./day/yr.			
		12. Pumping level below land surfaces: <u>9 1/2</u> ft. after <u>1</u> hrs. pumping <u>20</u> g.p.m. <u> </u> ft. after <u> </u> hrs. pumping <u> </u> g.p.m. Estimated maximum yield <u>50</u> g.p.m.			
		13. Water sample submitted: <u> </u> mo./day/yr. Yes <input type="checkbox"/> No <input checked="" type="checkbox"/> Date <u> </u>			
		14. Well head completion: <u> </u> Pitless adapter <u>12</u> inches above grade			
		15. Well grouted? <u>yes</u> With: <input checked="" type="checkbox"/> Neat cement <input type="checkbox"/> Bentonite <input type="checkbox"/> Concrete Depth: From <u>3</u> ft. to <u>10</u> ft.			
		16. Nearest source of possible contamination: ft. <u>100</u> Direction <u>SE</u> Type <u>septic</u> Well disinfected upon completion? <input checked="" type="checkbox"/> Yes <input type="checkbox"/> No			
		17. Pump: <input checked="" type="checkbox"/> Not installed Manufacturer's name <u> </u> Model number <u> </u> HP <u> </u> Volts <u> </u> Length of drop pipe <u> </u> ft. capacity <u> </u> g.p.m. Type: <input type="checkbox"/> Submersible <input type="checkbox"/> Turbine <input type="checkbox"/> Jet <input type="checkbox"/> Reciprocating <input type="checkbox"/> Centrifugal <input type="checkbox"/> Other			
18. Elevation:		20. Water well contractor's certification: This well was drilled under my jurisdiction and this report is true to the best of my knowledge and belief. <u>Price Water Well 193</u> Business name <u>RR3 Hutchinson</u> License No. <u> </u> Address <u> </u> Signed <u>John Davenport</u> Date <u>8-9-75</u> Authorized representative			
19. Remarks:					

Forward the white, blue and pink copies to the Department of Health and Environment

Form WWC-5