

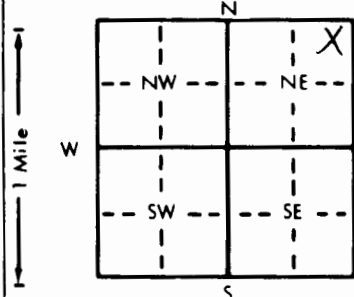
1 LOCATION OF WATER WELL: County: <u>Reno</u>	Fraction <u>NE 1/4 NE 1/4 NE 1/4</u>	Section Number <u>10</u>	Township Number <u>T 23 S</u>	Range Number <u>R 6 E 10</u>
--	---	-----------------------------	----------------------------------	---------------------------------

Distance and direction from nearest town or city street address of well if located within city?

1505 W. 17th. Hutchinson Kan.

2 WATER WELL OWNER: RR#, St. Address, Box # : City, State, ZIP Code	<u>James W. Ingram</u> <u>1505 W. 17th</u> <u>Hutchinson Kansas 67501</u>	Board of Agriculture, Division of Water Resources Application Number:
---	---	--

3 LOCATE WELL'S LOCATION WITH AN "X" IN SECTION BOX:	4 DEPTH OF COMPLETED WELL <u>22</u> ft. ELEVATION:
--	--

Depth(s) Groundwater Encountered 10 ft. 2. ft. 3. ft.WELL'S STATIC WATER LEVEL 10 ft. below land surface measured on mo/day/yr 12-21-92

Pump test data: Well water was ft. after hours pumping gpm

Est. Yield gpm: Well water was ft. after hours pumping gpm

Bore Hole Diameter in. to ft. and in. to ft.

WELL WATER TO BE USED AS: 5 Public water supply 8 Air conditioning 11 Injection well

① Domestic 3 Feedlot 6 Oil field water supply 9 Dewatering 12 Other (Specify below)

2 Irrigation 4 Industrial 7 Lawn and garden only 10 Monitoring well

Was a chemical/bacteriological sample submitted to Department? Yes No; If yes, mo/day/yr sample was submitted

Water Well Disinfected? Yes X No

5 TYPE OF BLANK CASING USED:	5 Wrought iron	8 Concrete tile	CASING JOINTS: Glued Clamped
------------------------------	----------------	-----------------	------------------------------

① Steel 3 RMP (SR) 6 Asbestos-Cement 9 Other (specify below) Welded

2 PVC 4 ABS 7 Fiberglass Threaded XBlank casing diameter 6 in. to 10 ft. Dia in. to ft. Dia in. to ft.

Casing height above land surface in. weight lbs./ft. Wall thickness or gauge No.

TYPE OF SCREEN OR PERFORATION MATERIAL:

① Steel 3 Stainless steel 5 Fiberglass 8 RMP (SR) 10 Asbestos-cement

2 Brass 4 Galvanized steel 6 Concrete tile 9 ABS 11 Other (specify)

SCREEN OR PERFORATION OPENINGS ARE:

1 Continuous slot 3 Mill slot 5 Gauzed wrapped 8 Saw cut 11 None (open hole)

② Louvered shutter 4 Key punched 6 Wire wrapped 9 Drilled holes

SCREEN-PERFORATED INTERVALS: From 10 ft. to 22 ft. From ft. to ft.

From ft. to ft. From ft. to ft.

GRAVEL PACK INTERVALS: From ft. to ft. From ft. to ft.

From ft. to ft. From ft. to ft.

6 GROUT MATERIAL:	1 Neat cement	② Cement grout	3 Bentonite	4 Other
-------------------	---------------	----------------	-------------	---------

Grout Intervals: From 0 ft. to 3 ft. From 7 ft. to 10 ft. From ft. to ft.

What is the nearest source of possible contamination:

1 Septic tank 4 Lateral lines 7 Pit privy 10 Livestock pens 14 Abandoned water well

2 Sewer lines 5 Cess pool 8 Sewage lagoon 11 Fuel storage 15 Oil well/Gas well

③ Watertight sewer lines 6 Seepage pit 9 Feedyard 12 Fertilizer storage 16 Other (specify below)

13 Insecticide storage

Direction from well? South How many feet? 20

FROM	TO	LITHOLOGIC LOG	FROM	TO	PLUGGING INTERVALS
------	----	----------------	------	----	--------------------

			<u>0</u>	<u>3</u>	<u>cement grout</u>
--	--	--	----------	----------	---------------------

			<u>3</u>	<u>7</u>	<u>sand</u>
--	--	--	----------	----------	-------------

			<u>7</u>	<u>10</u>	<u>cement grout</u>
--	--	--	----------	-----------	---------------------

			<u>10</u>	<u>22</u>	<u>gravel</u>
--	--	--	-----------	-----------	---------------

7 CONTRACTOR'S OR LANDOWNER'S CERTIFICATION: This water well was (1) constructed, (2) reconstructed, or (3) plugged under my jurisdiction and was completed on (mo/day/year) <u>12-21-92</u> and this record is true to the best of my knowledge and belief. Kansas Water Well Contractor's License No. <u>193</u> This Water Well Record was completed on (mo/day/yr) <u>3-30-93</u> under the business name of <u>Price Water Well Serv.</u> by (signature) <u>John Davenport</u>
---