


1 LOCATION OF WATER WELL:	Fraction	Section Number	Township Number	Range Number
County: <u>Reno</u>	<u>NE 1/4 NE 1/4 SW 1/4</u>	<u>11</u>	<u>T 23 S</u>	<u>R 6 E</u>

Distance and direction from nearest town or city street address of well if located within city?

720 Buchanan Hutchinson Kansas

2 WATER WELL OWNER:	RR#, St. Address, Box # :	City, State, ZIP Code :	Board of Agriculture, Division of Water Resources
<u>Mrs Helen Harrison</u>	<u>720 Buchanan</u>	<u>Hutchinson Kan 67501</u>	Application Number:

3 LOCATE WELL'S LOCATION WITH AN "X" IN SECTION BOX:	4 DEPTH OF COMPLETED WELL: <u>35</u> ft. ELEVATION:
--	---

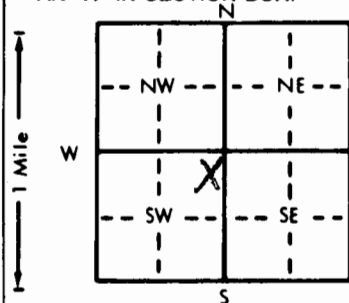

Depth(s) Groundwater Encountered	1. <u>16</u> ft.	2. <u>16</u> ft.	3. <u>16</u> ft.
WELL'S STATIC WATER LEVEL	<u>16</u> ft. below land surface measured on mo/day/yr	<u>3-14-88</u>	
Pump test data: Well water was	<u>17</u> ft. after	<u>1</u> hours pumping	<u>30</u> gpm
Est. Yield	<u>75</u> gpm	Well water was	<u>17</u> ft. after <u>1</u> hours pumping <u>30</u> gpm
Bore Hole Diameter	<u>9</u> in. to <u>18</u> ft. and <u>6</u> in. to <u>35</u> ft.		
WELL WATER TO BE USED AS:	5 Public water supply	8 Air conditioning	11 Injection well
	1 Domestic	3 Feedlot	6 Oil field water supply
	2 Irrigation	4 Industrial	9 Dewatering
		7 Lawn and garden only	12 Other (Specify below)
Was a chemical/bacteriological sample submitted to Department?	Yes <u>X</u> No <u>X</u>	If yes, mo/day/yr sample was submitted	
Water Well Disinfected?	Yes <u>X</u> No <u>X</u>		

5 TYPE OF BLANK CASING USED:	5 Wrought iron	8 Concrete tile	CASING JOINTS: Glued <u>X</u> Clamped
1 Steel	3 RMP (SR)	6 Asbestos-Cement	9 Other (specify below)
2 PVC	4 ABS	7 Fiberglass	Welded
			Threaded

Casing height above land surface	<u>12</u> in. weight		

TYPE OF SCREEN OR PERFORATION MATERIAL:	1 Steel	3 Stainless steel	5 Fiberglass	8 RMP (SR)	11 Other (specify)
	2 Brass	4 Galvanized steel	6 Concrete tile	9 ABS	12 None used (open hole)

SCREEN OR PERFORATION OPENINGS ARE:	5 Gauzed wrapped	8 Saw cut	11 None (open hole)
1 Continuous slot	3 Mill slot	6 Wire wrapped	9 Drilled holes
2 Louvered shutter	4 Key punched	7 Torch cut	10 Other (specify)



What is the nearest source of possible contamination:	1 Septic tank	4 Lateral lines	7 Pit privy	10 Livestock pens	14 Abandoned water well
	2 Sewer lines	5 Cess pool	8 Sewage lagoon	11 Fuel storage	15 Oil well/Gas well
	3 Watertight sewer lines	6 Seepage pit	9 Feedyard	12 Fertilizer storage	16 Other (specify below)
Direction from well?	<u>South</u>			How many feet?	<u>40</u>

FROM	TO	LITHOLOGIC LOG	FROM	TO	LITHOLOGIC LOG
<u>0</u>	<u>2</u>	<u>Sandy soil</u>			
<u>2</u>	<u>9</u>	<u>Sandy clay</u>			
<u>9</u>	<u>13</u>	<u>fine sand</u>			
<u>13</u>	<u>16</u>	<u>fine gravel</u>			
<u>16</u>	<u>35</u>	<u>medium gravel</u>			

7 CONTRACTOR'S OR LANDOWNER'S CERTIFICATION:	This water well was <u>1</u> constructed, (2) reconstructed, or (3) plugged under my jurisdiction and was completed on (mo/day/year) <u>3-14-88</u> and this record is true to the best of my knowledge and belief. Kansas Water Well Contractor's License No. <u>193</u> This Water Well Record was completed on (mo/day/yr) <u>7-30-88</u> under the business name of <u>Price Water Well Service</u> by (signature) <u>John Davenport</u>
--	--

INSTRUCTIONS: Use typewriter or ball point pen. PLEASE PRESS FIRMLY and PRINT clearly. Please fill in blanks. underline or circle the correct answers. Send top three copies to Kansas Department of Health and Environment, Bureau of Water Protection, Topeka, Kansas 66620-7320, Telephone: 913-862-9360. Send one to WATER WELL OWNER and retain one for your records.

OFFICE USE ONLY

T

3

R

5

EW

SEC. 11

1/4

1/4