


1 LOCATION OF WATER WELL:	Fraction	Section Number	Township Number	Range Number
County: <u>Reno</u>	SW $\frac{1}{4}$ SE $\frac{1}{4}$ SW $\frac{1}{4}$	11	T 23 S	R 6 E <u>W</u>

Distance and direction from nearest town or city street address of well if located within city?

85°N & 11°W of NW Corner of Green Garden Drive & 4th Ave., Hutchinson, KS 52895021 RW-1

2	WATER WELL OWNER:	Ruffin Oil Company	
	RR#, St. Address, Box # :	1522 S. Florence, P.O. Box 17087	Board of Agriculture, Division of Water Resources
	City, State, ZIP Code :	Wichita, KS 67217	Application Number:

3 LOCATE WELL'S LOCATION WITH AN "X" IN SECTION BOX: 4 DEPTH OF COMPLETED WELL... 30.0 ... ft. ELEVATION: Approx. Surface Elev.: 1535 ...

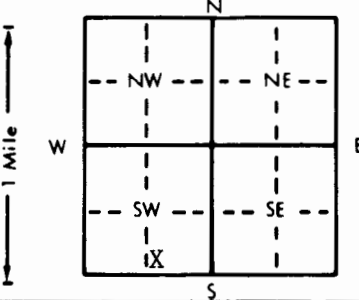

4 DEPTH OF COMPLETED WELL... 30.0 ft. ELEVATION Approx. Surface Elev.: 1535
Depth(s) Groundwater Encountered 1. 9.0 ft. 2. ft. 3. ft.
WELL'S STATIC WATER LEVEL .. 7.6 ft. below land surface measured on mo/day/yr 07/11/90
Pump test data: Well water was ft. after hours pumping gpm
Est. Yield N/A gpm: Well water was ft. after hours pumping gpm
Bore Hole Diameter. 13.0 in. to 30.0 ft., and in. to ft.
WELL WATER TO BE USED AS: 5 Public water supply 8 Air conditioning 11 Injection well
1 Domestic 3 Feedlot 6 Oil field water supply 9 Dewatering 12 Other (Specify below)
2 Irrigation 4 Industrial 7 Lawn and garden only 10 Monitoring well
Was a chemical/bacteriological sample submitted to Department? Yes No X; If yes, mo/day/yr sample was sub-
mitted Water Well Disinfected? Yes No X

5	TYPE OF BLANK CASING USED:		5 Wrought iron	8 Concrete tile	CASING JOINTS: Glued Clamped
	1 Steel	3 RMP (SR)	6 Asbestos-Cement	9 Other (specify below)	Welded
	2 PVC	4 ABS	7 Fiberglass		Threaded X

Blank casing diameter 5.0 . in. to 8.0 . ft., Dia in. to ft., Dia in. to ft.
Casing height above land surface. . . 32.0 . in., weight lbs./ft. Wall thickness or gauge No. **Schedule 40**

TYPE OF SCREEN OR PERFORATION MATERIAL:

1 Steel	3 Stainless steel	5 Fiberglass	7 PVC	10 Asbestos-cement
2 Brass	4 Galvanized steel	6 Concrete tile	8 RMP (SR)	11 Other (specify)
			9 ABS	12 None used (open hole)

SCREEN OR PERFORATION OPENINGS ARE:

1 Continuous slot	<input checked="" type="radio"/> 3 Mill slot	5 Gauzed wrapped	8 Saw cut	11 None (open hole)
2 Louvered shutter	4 Key punched	6 Wire wrapped	9 Drilled holes	
		7 Torch cut	10 Other (specify)	

SCREEN-PERFORATED INTERVALS:	From 8.0 ft. to 28.0 ft.,	From ft. to ft.
	From ft. to ft.,	From ft. to ft.
GRAVEL PACK INTERVALS:	From 6.5 ft. to 30.0 ft.,	From ft. to ft.
	From ft. to ft.,	From ft. to ft.

6 GROUT MATERIAL: 1 Neat cement 2 Cement grout 3 Bentonite 4 Other
Grout Intervals: From 0 ft. to 4.5 ft., From 4.5 ft. to 6.5 ft., From ft. to ft.

What is the nearest source of possible contamination:

1 Septic tank	4 Lateral lines	7 Pit privy	10 Livestock pens	14 Abandoned water well
2 Sewer lines	5 Cess pool	8 Sewage lagoon	11 Fuel storage	15 Oil well/Gas well
3 Watertight sewer lines	6 Seepage pit	9 Feedyard	12 Fertilizer storage	16 Other (specify below)
			13 Insecticide storage

Direction from well? Northwest		How many feet? 11	
--------------------------------	--	-------------------	--

[illegible]

7 CONTRACTOR'S OR LANDOWNER'S CERTIFICATION: This water well was (1) constructed, (2) reconstructed, or (3) plugged under my jurisdiction and was completed on (mo/day/year) 07/10/90 and this record is true to the best of my knowledge and belief. Kansas Water Well Contractor's License No. 416 This Water Well Record was completed on (mo/day/yr) 9/19/90 under the business name of Terracon Consultants, Inc. by (signature) [Signature]