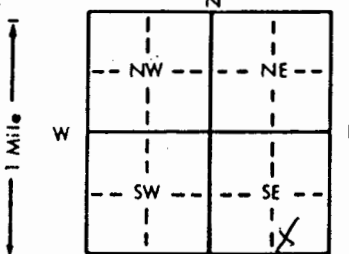


1 LOCATION OF WATER WELL: County: <b>RENO</b>		Fraction: <b>SW 1/4 SE 1/4 SE 1/4</b>		Section Number: <b>11</b>		Township Number: <b>T 23</b>		Range Number: <b>S 6</b>	
Distance and direction from nearest town or city street address of well if located within city? <b>630 East 5th, Hutchinson KS 67501</b>									
2 WATER WELL OWNER: <b>Carl King</b> RR#, St. Address, Box # : <b>4 Lawndale</b> City, State, ZIP Code : <b>Hutchinson KS 67502</b> Board of Agriculture, Division of Water Resources Application Number:									
<b>INACTIVE</b> 2 Irrigation 4 Industrial 7 Lawn and garden only 10 Observation well Was a chemical/bacteriological sample submitted to Department? Yes <b>No</b> .....; If yes, mo/day/yr sample was submitted <b>No</b> Water Well Disinfected? Yes <b>X</b> No						
5 TYPE OF BLANK CASING USED: X 1 Steel <b>galvanized</b> RMP (SR) 5 Wrought iron 8 Concrete tile CASING JOINTS: Glued <b>Clamped</b> 2 PVC 4 ABS 6 Asbestos-Cement 9 Other (specify below) Welded 7 Fiberglass Threaded Blank casing diameter <b>14</b> in. hole) SCREEN OR PERFORATION OPENINGS ARE: 1 Continuous slot 3 Mill slot 5 Gauzed wrapped 8 Saw cut 11 None (open hole) 2 Louvered shutter 4 Key punched 6 Wire wrapped 9 Drilled holes 12 Other (specify) <b>NA</b> SCREEN-PERFORATED INTERVALS: From <b>NA</b> ft. to <b>NA</b> ft., From <b>NA</b> ft. to <b>NA</b> ft., From <b>NA</b> ft. to <b>NA</b> ft. GRAVEL PACK INTERVALS: From <b>NA</b> ft. to <b>NA</b> ft., From <b>NA</b> ft. to <b>NA</b> ft., From <b>NA</b> ft. to <b>NA</b> ft.									
6 GROUT MATERIAL: 1 Neat cement X 2 Cement grout 3 Bentonite 4 Other <b>Sand</b> Grout Intervals: From <b>14</b> ft. to <b>0</b> ft., From <b>0</b> ft. to <b>0</b> ft., From <b>0</b> ft. to <b>0</b> ft., From <b>0</b> ft. to <b>0</b> ft. What is the nearest source of possible contamination: 1 Septic tank 4 Lateral lines 7 Pit privy 10 Livestock pens 14 Abandoned water well 2 Sewer lines 5 Cess pool 8 Sewage lagoon 11 Fuel storage 15 Oil well/Gas well 3 Watertight sewer lines 6 Seepage pit 9 Feedyard 12 Fertilizer storage 16 Other (specify below) Direction from well? <b>How many feet?</b> FROM TO LITHOLOGIC LOG FROM TO LITHOLOGIC LOG <b>14</b> <b>0</b> <b>Cement</b>									
7 CONTRACTOR'S OR LANDOWNER'S CERTIFICATION: This water well was <b>plugged under my jurisdiction and was completed on (mo/day/year) November 14, 1992</b> and this record is true to the best of my knowledge and belief. Kansas Water Well Contractor's License No. <b>11/16/92</b> under the business name of <b>Advance Termite &amp; Pest Control, Inc.</b> by (signature) <b>Al Wells</b> <b>Al Wells</b> INSTRUCTIONS: Use typewriter or ball point pen, <b>PLEASE PRESS FIRMLY</b> and <b>PRINT</b> clearly. Please fill in blanks, underline or circle the correct answers. Send top three copies to Kansas Department of Health and Environment, Division of Environment, Environmental Geology Section, Topeka, KS 66620. Send one to WATER WELL OWNER and retain one for your records.									