

1 LOCATION OF WATER WELL:	Fraction	Section Number	Township Number	Range Number
County: <u>Reno</u>	<u>SE 1/4 SE 1/4 NW 1/4</u>	<u>12</u>	<u>T 23 S</u>	<u>R 6 E</u>

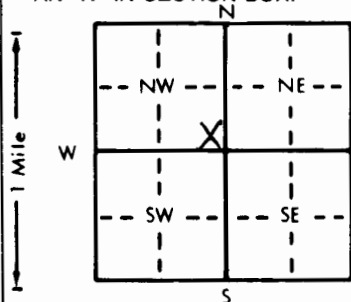
Distance and direction from nearest town or city street address of well, if located within city?

1219 N. Main Hutchinson

2 WATER WELL OWNER:	Board of Agriculture, Division of Water Resources
RR#, St. Address, Box # :	Application Number:
City, State, ZIP Code :	

Elliot H mortuary1219 N. MainHutchinson Kan 67501

3 LOCATE WELL'S LOCATION WITH AN "X" IN SECTION BOX:	4 DEPTH OF COMPLETED WELL: <u>35</u> ft. ELEVATION:
--	---

Depth(s) Groundwater Encountered 1. 16 ft. 2. 16 ft. 3. 16 ft.WELL'S STATIC WATER LEVEL 16 ft. below land surface measured on mo/day/yr 6-21-93Pump test data: Well water was 17 ft. after 1 hours pumping 30 gpmEst. Yield 75 gpm: Well water was 17 ft. after 1 hours pumping 30 gpmBore Hole Diameter 9 in. to 17 ft., and 6 in. to 35 ft.

WELL WATER TO BE USED AS:

1 Domestic	3 Feedlot	6 Oil field water supply	8 Air conditioning	11 Injection well
------------	-----------	--------------------------	--------------------	-------------------

2 Irrigation	4 Industrial	7 Lawn and garden only	9 Dewatering	12 Other (Specify below)
--------------	--------------	------------------------	--------------	--------------------------

Was a chemical/bacteriological sample submitted to Department? Yes X No X; If yes, mo/day/yr sample was submittedWater Well Disinfected? Yes X No X

5 TYPE OF BLANK CASING USED:	5 Wrought iron	8 Concrete tile	CASING JOINTS: Glued <u>X</u> Clamped
------------------------------	----------------	-----------------	---------------------------------------

1 Steel	3 RMP (SR)	6 Asbestos-Cement	9 Other (specify below)	Welded
---------	------------	-------------------	-------------------------	--------

2 PVC	4 ABS	7 Fiberglass		Threaded
-------	-------	--------------	--	----------

Blank casing diameter 6 in. to 25 ft., Dia 6 in. to 25 ft., Dia 6 in. to 25 ft.Casing height above land surface 12 in., weight 12 lbs./ft. Wall thickness or gauge No. 250

TYPE OF SCREEN OR PERFORATION MATERIAL:

1 Steel	3 Stainless steel	5 Fiberglass	7 RMP (SR)	10 Asbestos-cement
---------	-------------------	--------------	------------	--------------------

2 Brass	4 Galvanized steel	6 Concrete tile	9 ABS	11 Other (specify)
---------	--------------------	-----------------	-------	--------------------

				12 None used (open hole)
--	--	--	--	--------------------------

SCREEN OR PERFORATION OPENINGS ARE:

1 Continuous slot	3 Mill slot	5 Gauzed wrapped	8 Saw cut	11 None (open hole)
-------------------	-------------	------------------	-----------	---------------------

2 Louvered shutter	4 Key punched	6 Wire wrapped	9 Drilled holes	
--------------------	---------------	----------------	-----------------	--

		7 Torch cut	10 Other (specify)	
--	--	-------------	--------------------	--

SCREEN-PERFORATED INTERVALS: From 25 ft. to 35 ft., From 25 ft. to 35 ft., From 25 ft. to 35 ft., From 25 ft. to 35 ft.GRAVEL PACK INTERVALS: From 25 ft. to 35 ft., From 25 ft. to 35 ft., From 25 ft. to 35 ft., From 25 ft. to 35 ft.7 CONTRACTOR'S OR LANDOWNER'S CERTIFICATION: This water well was (1) constructed, (2) reconstructed, or (3) plugged under my jurisdiction and was completed on (mo/day/year) 6-21-93 and this record is true to the best of my knowledge and belief. KansasWater Well Contractor's License No. 193 This Water Well Record was completed on (mo/day/yr) 7-1-93under the business name of Price Water Well Serv. by (signature) John Davenport