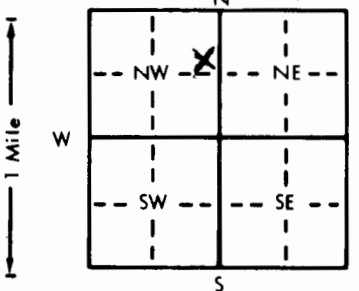


COPY - HP

1 LOCATION OF WATER WELL:		Fraction	Section Number	Township Number	Range Number
County: Reno		SE 1/4 NE 1/4 NW 1/4	13	T 23 S	R 6W E/W
Distance and direction from nearest town or city street address of well if located within city? 100 W. 2nd.					
2 WATER WELL OWNER: Sunflower Electric Co. RR#, St. Address, Box #: 100 W. 2nd. City, State, ZIP Code: Hutchinson, KS 67501 Board of Agriculture, Division of Water Resources Application Number:					
3 LOCATE WELL'S LOCATION WITH AN "X" IN SECTION BOX:		4 DEPTH OF COMPLETED WELL: 50 ft. ELEVATION:			
		Depth(s) Groundwater Encountered 1. 14 ft. 2. 15 ft. 3. 9/12/82 WELL'S STATIC WATER LEVEL 15 ft. below land surface measured on mo/day/yr Pump test data: Well water was NO ft. after 11 hours pumping gpm Est. Yield 11 gpm: Well water was 50 ft. after 11 hours pumping gpm Bore Hole Diameter 11 in. to 50 ft. and 11 in. to 50 ft. WELL WATER TO BE USED AS: 1 Domestic 3 Feedlot 5 Public water supply 11 Injection well 2 Irrigation 4 Industrial 6 Oil field water supply 9 Dewatering 12 Other (Specify below) 7 Lawn and garden only 10 Observation well Was a chemical/bacteriological sample submitted to Department? Yes NO No NO If yes, mo/day/yr sample was submitted			
5 TYPE OF BLANK CASING USED: 1 Steel 3 RMP (SR) 5 Wrought iron 8 Concrete tile CASING JOINTS: Glued X Clamped 2 PVC 4 ABS 6 Asbestos-Cement 9 Other (specify below) Welded 7 Fiberglass Threaded Blank casing diameter 5 in. to 0-10 ft. Dia 160 in. to 216 lbs./ft. Wall thickness or gauge No. 216 Casing height above land surface 24 in. weight 160 lbs./ft. Wall thickness or gauge No. 216 TYPE OF SCREEN OR PERFORATION MATERIAL: 1 Steel 3 Stainless steel 5 Fiberglass 7 PVC 10 Asbestos-cement 2 Brass 4 Galvanized steel 6 Concrete tile 8 RMP (SR) 11 Other (specify) 9 ABS 12 None used (open hole) SCREEN OR PERFORATION OPENINGS ARE: 1 Continuous slot 3 Mill slot 5 Gauzed wrapped 8 Saw cut 11 None (open hole) 2 Louvered shutter 4 Key punched 6 Wire wrapped 9 Drilled holes 7 Torch cut 10 Other (specify) SCREEN-PERFORATED INTERVALS: From 10 ft. to 50 ft. From 10 ft. to 50 ft. GRAVEL PACK INTERVALS: From 10 ft. to 50 ft. From 10 ft. to 50 ft.					
6 GROUT MATERIAL: 1 Neat cement 2 Cement grout 3 Bentonite 4 Other Grout Intervals: From 0 ft. to 10 ft. From 10 ft. to 10 ft. From 10 ft. to 10 ft. What is the nearest source of possible contamination: 1 Septic tank 4 Lateral lines 7 Pit privy 10 Livestock pens 14 Abandoned water well 2 Sewer lines 5 Cess pool 8 Sewage lagoon 11 Fuel storage 15 Oil well/Gas well 3 Watertight sewer lines 6 Seepage pit 9 Feedyard 12 Fertilizer storage 16 Other (specify below) Direction from well? North How many feet? 35 13 Insecticide storage Disposal well					
7 CONTRACTOR'S OR LANDOWNER'S CERTIFICATION: This water well was (1) constructed, (2) reconstructed, or (3) plugged under my jurisdiction and was completed on (mo/day/year) 9/2/82 and this record is true to the best of my knowledge and belief. Kansas Water Well Contractor's License No. 134 This Water Well Record was completed on (mo/day/yr) 9/8/82 under the business name of Rosencrants-Bemis Ent. by (signature) Diane Schoof					
INSTRUCTIONS: Use typewriter or ball point pen, PLEASE PRESS FIRMLY and PRINT clearly. Please fill in blanks, underline or circle the correct answers. Send top three copies to Kansas Department of Health and Environment, Division of Environment, Environmental Geology Section, Topeka, KS 66620. Send one to WATER WELL OWNER and retain one for your records.					