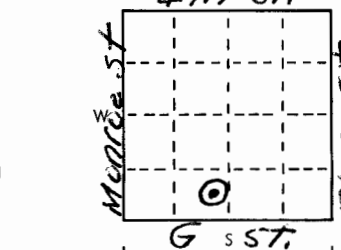


USE TYPEWRITER OR BALL
POINT PEN-PRESS FIRMLY,
PRINT CLEARLY.

WATER WELL RECORD
KSA 82g-1201-1215

T		R		FW		sec	1/4	1/4	1/4 No

Kansas State Dept. Of Health
(Water Well Contractors)
Forbes-Bldg. 740
Topeka, Kansas 66620

County Reno		Township name Reno		Fraction SE4, SW4		Section number 13		Town number T23S		Range number R6W	
1 Location of well: Distance and direction from nearest town or city: IN Hutchinson Street address of well location if in city: 25 W. Ave E						3 Owner of well: Winchester Packing Co. Address: Hutchinson, Kansas					
Locate with "X" in section below:  Sketch map: Lot 9, West "E" St						4 Well depth: 65.45 ft. Date of completion 3/1/75 Well diameter 12 in. 5 <input type="checkbox"/> Cable tool <input type="checkbox"/> Rotary <input type="checkbox"/> Driven <input type="checkbox"/> Dug <input type="checkbox"/> Hollow rod <input type="checkbox"/> Jetted <input type="checkbox"/> Bored <input checked="" type="checkbox"/> Reverse rotary 6 Use: <input type="checkbox"/> Domestic <input type="checkbox"/> Public supply <input checked="" type="checkbox"/> Industry <input type="checkbox"/> Irrigation <input type="checkbox"/> Air conditioning <input type="checkbox"/> Commercial <input type="checkbox"/> Test well <input type="checkbox"/> _____ 7 Casing: Material St. Height: above/below Threaded <input type="checkbox"/> Welded <input checked="" type="checkbox"/> Surface 3 in. Diam. 12 in. to 65 ft. depth Drive shoe? <input type="checkbox"/> Yes <input checked="" type="checkbox"/> No _____ in. to _____ ft. depth 8 Screen: Manufacturer Layne Type 304 Dia. 12" Slot/gauze .105" Length 15' Set between 50 ft. and 65 ft. Fittings: Gravel pack <input checked="" type="checkbox"/> Yes <input type="checkbox"/> No Size range of material 1/8" 9 Static water level: 18.2 ft. below land surface Date 3/15/75 10 Pumping level below land surfaces: 28 ft. after 4 hrs. pumping 800 g.p.m. _____ ft. after _____ hrs. pumping _____ g.p.m. Estimated maximum yield 1500 g.p.m. 11 Water sample submitted: <input type="checkbox"/> Yes <input checked="" type="checkbox"/> No Date _____ 12 Well head completion: <input type="checkbox"/> Pitless adapter <input checked="" type="checkbox"/> Inches above grade 36" 13 Well grouted? <input checked="" type="checkbox"/> Yes <input type="checkbox"/> No <input checked="" type="checkbox"/> Neat cement <input type="checkbox"/> Bentonite <input type="checkbox"/> _____ Depth: From 0 ft. to 20 ft. 14 Nearest source of possible contamination: ft. 150 Direction West Type sewer Well disinfected upon completion? <input checked="" type="checkbox"/> Yes <input type="checkbox"/> No 15 Pump: <input type="checkbox"/> Not installed Manufacturer's name LAYNE Model number WRK HP 25 Volts 460 Length of drop pipe 50 ft. capacity 500 g.p.m. Type: <input type="checkbox"/> Submersible <input checked="" type="checkbox"/> Turbine <input type="checkbox"/> Jet <input type="checkbox"/> Reciprocating <input type="checkbox"/> Centrifugal <input type="checkbox"/> Other 16 Remarks: elevation Topography: <input type="checkbox"/> Hill <input type="checkbox"/> Slope <input type="checkbox"/> Upland <input checked="" type="checkbox"/> Valley 17 Water well contractor's certification: This well was drilled under my jurisdiction and this report is true to the best of my knowledge and belief. Layne Western Co. 102 Business name License No. Address 1011 W. Harry, Wich. Signed [Signature] Date 3/18/75 Authorized representative					