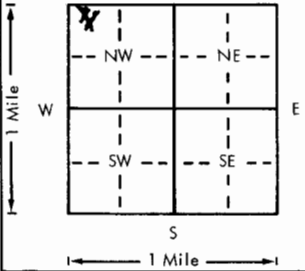
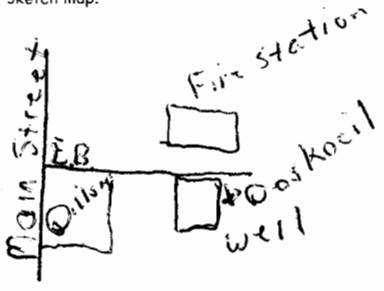


USE TYPEWRITER OR BALL
POINT PEN-PRESS FIRMLY,
PRINT CLEARLY.

WATER WELL RECORD
KSA 82a-1201-1215

Kansas Department of Health and
Environment-Division of Environment
(Water well Contractors)
Topeka, Kansas 66620

1. Location of well:		County Reno	Fraction NW/4 SW/4 SW/4	Section number 13	Township number T 23 S	Range number R 6 E
2. Distance and direction from nearest town or city: Street address of well location if in city: 17 East B St.				3. Owner of well: Doskocil Sausage Co. R.R. or street: 321 North Main City, state, zip code: South Hutchinson, Kansas 67505		
Locate with "X" in section below: 		Sketch map: 		6. Bore hole dia. 10 1/8 in. Completion date 7/10/79 Well depth 45 ft.		
5. Type and color of material				7. <input checked="" type="checkbox"/> Cable tool <input checked="" type="checkbox"/> Rotary <input type="checkbox"/> Driven <input type="checkbox"/> Dug <input type="checkbox"/> Hollow rod <input type="checkbox"/> Jetted <input type="checkbox"/> Bored <input type="checkbox"/> Reverse rotary		
				8. Use: <input type="checkbox"/> Domestic <input type="checkbox"/> Public supply <input type="checkbox"/> Industry <input type="checkbox"/> Irrigation <input type="checkbox"/> Air conditioning <input type="checkbox"/> Stock <input type="checkbox"/> Lawn <input type="checkbox"/> Oil field water <input checked="" type="checkbox"/> Other Disposal		
				9. Casing: Material <input type="checkbox"/> Height: Above or below Threaded <input type="checkbox"/> Welded <input type="checkbox"/> Surface 18 in. RMP <input type="checkbox"/> PVC <input checked="" type="checkbox"/> Weight 160 lbs./ft. Dia. 5 in. to 2 1/2 ft. depth Wall Thickness: inches or Dia. 5 in. to 2 1/2 ft. depth gauge No. 258		
				10. Screen: Manufacturer's name Century (see) Type sawtooth Dia. 5 Slot/gauze 1/16 Length 20 Set between 25 ft. and 45 ft. Gravel pack? yes Size range of material 1/8-1/4		
				11. Static water level: 15 ft. below land surface Date 7/10/79		
				12. Pumping level below land surfaces: 20 ft. after 1 hrs. pumping 70 g.p.m. ft. after hrs. pumping g.p.m. Estimated maximum yield 80 g.p.m.		
				13. Water sample submitted: X Yes <input checked="" type="checkbox"/> No Date		
				14. Well head completion: 18 Pitless adapter 18 inches above grade		
				15. Well grouted? yes With: <input checked="" type="checkbox"/> Neat cement <input type="checkbox"/> Bentonite <input type="checkbox"/> Concrete Depth: From 0 ft. to 10 ft.		
				16. Nearest source of possible contamination: ft. Direction none Type Well disinfected upon completion? <input type="checkbox"/> Yes <input checked="" type="checkbox"/> No		
				17. Pump: <input checked="" type="checkbox"/> Not installed Manufacturer's name Model number HP Volts Length of drop pipe ft. capacity g.p.m. Type: <input type="checkbox"/> Submersible <input type="checkbox"/> Turbine <input type="checkbox"/> Jet <input type="checkbox"/> Reciprocating <input type="checkbox"/> Centrifugal <input type="checkbox"/> Other		
				20. Water well contractor's certification: This well was drilled under my jurisdiction and this report is true to the best of my knowledge and belief. Rosencrantz-Bemis Ent. Inc. 131 Business name License No. Address 1211 W. 4th, Hutchinson, Ks Signed Mike Dawes Date 7-20-79 Authorized representative		
18. Elevation:		19. Remarks: Disposal or Aircorntin water				
Topography: <input type="checkbox"/> Hill <input type="checkbox"/> Slope <input type="checkbox"/> Upland <input type="checkbox"/> Valley						