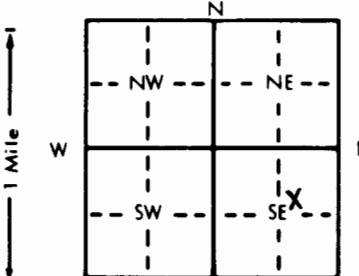


1 LOCATION OF WATER WELL:		Fraction	Section Number	Township Number	Range Number
County: Reno		SW 1/4 NE 1/4 SE 1/4	14	T 23 S	R 6 EW
Distance and direction from nearest town or city street address of well if located within city? 305 South Monroe Street, Hutchinson, Kansas MW 7					
2 WATER WELL OWNER: Krause Plow Corp, Inc.					
RR#, St. Address, Box # : 305 S. Monroe Street			Board of Agriculture, Division of Water Resources		
City, State, ZIP Code : Hutchinson, KS 67501			Application Number:		
3 LOCATE WELL'S LOCATION WITH AN "X" IN SECTION BOX:		4 DEPTH OF COMPLETED WELL: 20 ft. ELEVATION:			
		WELL'S STATIC WATER LEVEL 18.12 ft. below land surface measured on mo/day/yr 08-13-92			
		Bore Hole Diameter 7 5/8 in. to 20 ft., and 20 in. to 20 ft.			
		WELL WATER TO BE USED AS: 5 Public water supply 8 Air conditioning 11 Injection well			
		1 Domestic 3 Feedlot 6 Oil field water supply 9 Dewatering 12 Other (Specify below)			
		2 Irrigation 4 Industrial 7 Lawn and garden only 10 Monitoring well			
		Was a chemical/bacteriological sample submitted to Department? Yes No ; If yes, mo/day/yr sample was submitted			
		Water Well Disinfected? Yes No			
5 TYPE OF BLANK CASING USED:					
1 Steel 3 RMP (SR) 5 Wrought iron 8 Concrete tile CASING JOINTS: Glued Clamped					
2 PVC 4 ABS 6 Asbestos-Cement 9 Other (specify below) Welded Threaded					
7 Fiberglass					
Casing height above land surface 24 in., weight 24 lbs./ft. Wall thickness or gauge No. Sch. 40					
TYPE OF SCREEN OR PERFORATION MATERIAL:					
1 Steel 3 Stainless steel 5 Fiberglass 8 RMP (SR) 10 Asbestos-cement					
2 Brass 4 Galvanized steel 6 Concrete tile 9 ABS 11 Other (specify)					
12 None used (open hole)					
SCREEN OR PERFORATION OPENINGS ARE:					
1 Continuous slot 3 Mill slot 5 Gauzed wrapped 8 Saw cut 11 None (open hole)					
2 Louvered shutter 4 Key punched 6 Wire wrapped 9 Drilled holes					
7 Torch cut 10 Other (specify)					
What is the nearest source of possible contamination:					
1 Septic tank 4 Lateral lines 7 Pit privy 10 Livestock pens 14 Abandoned water well					
2 Sewer lines 5 Cess pool 8 Sewage lagoon 11 Fuel storage 15 Oil well/Gas well					
3 Watertight sewer lines 6 Seepage pit 9 Feedyard 12 Fertilizer storage 16 Other (specify below)					
13 Insecticide storage					
Direction from well? Northeast How many feet? 200					
FROM	TO	LITHOLOGIC LOG	FROM	TO	PLUGGING INTERVALS
0	9	Sandy clay, dark brown			Flush mount cover
9	15	Sand, light brown, fine to medium			Above ground cover
15	20	Sand, light brown, fine to coarse			KDHE Site ID # 00096414
7 CONTRACTOR'S OR LANDOWNER'S CERTIFICATION: This water well was (1) constructed, (2) reconstructed, or (3) plugged under my jurisdiction and was completed on (mo/day/year) 08-05-92 and this record is true to the best of my knowledge and belief. Kansas Water Well Contractor's License No. 527 This Water Well Record was completed on (mo/day/yr) 09-01-92 under the business name of GeoCore Services, Inc. by (signature) Dale A. Rohl					
INSTRUCTIONS: Use typewriter or ball point pen. PLEASE PRESS FIRMLY and PRINT clearly. Please fill in blanks, underline or circle the correct answers. Send top three copies to Kansas Department of Health and Environment, Bureau of Water, Topeka, Kansas 66620-0001. Telephone: 913-296-5545. Send one to WATER WELL OWNER and retain one for your records.					