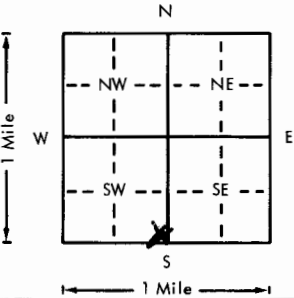
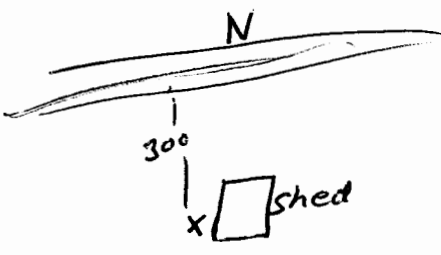


USE TYPEWRITER OR BALL
POINT PEN-PRESS FIRMLY,
PRINT CLEARLY.

WATER WELL RECORD
KSA 82a-1201-1215

Kansas Department of Health and
Environment-Division of Environment
(Water well Contractors)
Topeka, Kansas 66620

1. Location of well:		County Reno	Fraction SE 1/4 SE 1/4 SW 1/4	Section number 16	Township number T 23 S	Range number R 6 E
2. Distance and direction from nearest town or city: Street address of well location if in city:		1 1/2 Mi. W of Hutchinson, KS		3. Owner of well: Reno Co. land f/H R.R. or street: Rd 1 City, state, zip code: Hutchinson, KS 67501		
4. Locate with "X" in section below:		Sketch map:		6. Bore hole dia. 10 in. Completion date 8-10-77 Well depth 40 ft. 65 ft.		
				7. Cable tool <input checked="" type="checkbox"/> Rotary <input type="checkbox"/> Driven <input type="checkbox"/> Dug <input type="checkbox"/> Hollow rod <input type="checkbox"/> Jetted <input type="checkbox"/> Bored <input type="checkbox"/> Reverse rotary		
5. Type and color of material		From		To		8. Use: <input type="checkbox"/> Domestic <input type="checkbox"/> Public supply <input type="checkbox"/> Industry <input type="checkbox"/> Irrigation <input type="checkbox"/> Air conditioning <input type="checkbox"/> Stock <input type="checkbox"/> Lawn <input type="checkbox"/> Oil field water <input checked="" type="checkbox"/> Other
Brown + yellow silt		0		10		9. Casing: Material PLST Height Above or below Threaded <input type="checkbox"/> Welded <input type="checkbox"/> Surface 12 in. RMP <input checked="" type="checkbox"/> PVC <input type="checkbox"/> Weight 1.95 lbs./ft. Dia. 6 in. to 40 ft. depth Wall Thickness: inches or Dia. <input type="checkbox"/> in. to <input type="checkbox"/> ft. depth Gauge No. 200
Brown Clay		10		21		10. Screen: Manufacturer's name J+L Type RMP Dia. 6 Slot gauge .060 Length 8 Set between 32 ft. and 40 ft. ft. and <input type="checkbox"/> ft. Gravel pack? <input checked="" type="checkbox"/> Yes Size range of material F-1/2
Fine Sand		21		41		11. Static water level: <input type="checkbox"/> mo./day/yr. 20.5 ft. below land surface Date 8-10-77
Hard white rock		41		41.5		12. Pumping level below land surfaces: 25 ft. after 1 hrs. pumping 25 g.p.m. <input type="checkbox"/> ft. after <input type="checkbox"/> hrs. pumping <input type="checkbox"/> g.p.m. Estimated maximum yield 50 g.p.m.
						13. Water sample submitted: <input type="checkbox"/> Yes <input checked="" type="checkbox"/> No Date <input type="checkbox"/>
						14. Well head completion: <input checked="" type="checkbox"/> Pitless adapter <input checked="" type="checkbox"/> 12 inches above grade
						15. Well grouted? <input checked="" type="checkbox"/> Yes With: <input checked="" type="checkbox"/> Neat cement <input type="checkbox"/> Bentonite <input type="checkbox"/> Concrete Depth: From 3 ft. to 13 ft.
						16. Nearest source of possible contamination: city ft. 300 Direction N Type R Well disinfected upon completion? <input checked="" type="checkbox"/> Yes <input type="checkbox"/> No
						17. Pump: <input type="checkbox"/> Not installed Manufacturer's name Valley Model number 51248 HP 1/2 Volts 270 Length of drop pipe 30 ft. capacity 12 g.p.m. Type: <input checked="" type="checkbox"/> Submersible <input type="checkbox"/> Turbine <input type="checkbox"/> Jet <input type="checkbox"/> Reciprocating <input type="checkbox"/> Centrifugal <input type="checkbox"/> Other
18. Elevation:		19. Remarks:		20. Water well contractor's certification: This well was drilled under my jurisdiction and this report is true to the best of my knowledge and belief. Miller Water Well 137 Business name Hutchinson, KS License No. SE565W Address Joe Miller 6-15-78 Signed Joe Miller Date 6-15-78 Authorized representative		

Forward the white, blue and pink copies to the Department of Health and Environment

Form WWC-5