

1 LOCATION OF WATER WELL: County: <u>RENO</u>	Fraction <u>SE 1/4 SE 1/4 NW 1/4</u>	Section Number <u>22</u>	Township Number <u>T 23 S</u>	Range Number <u>R 1 E/W</u>
--	---	-----------------------------	----------------------------------	--------------------------------


Distance and direction from nearest town or city street address of well if located within city?

1/2 MILE WEST OF SOUTH HUTCHINSON

2 WATER WELL OWNER: RENO BY PRODUCTS
RR#, St. Address, Box # : RT 1
City, State, ZIP Code : HUTCHINSON, KS 67501

Board of Agriculture, Division of Water Resources
Application Number:

3 LOCATE WELL'S LOCATION WITH AN "X" IN SECTION BOX: 4 DEPTH OF COMPLETED WELL... 49 ft. ELEVATION: 1110

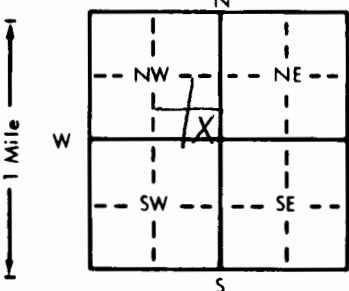

4. DEPTH OF COMPLETED WELL. 49 ft. ELEVATION: _____

Depth(s) Groundwater Encountered 1. ~~1~~ ft. 2. _____ ft. 3. _____ ft.

WELL'S STATIC WATER LEVEL 17 ft. below land surface measured on mo/day/yr _____

Pump test data: Well water was 18 ft. after 2 hours pumping 20 gpm

Est. Yield 100 gpm; Well water was _____ ft. after _____ hours pumping _____ gpm

Bore Hole Diameter 10 in. to 50 ft., and _____ in. to _____ ft.

WELL WATER TO BE USED AS:

<u>1</u> Domestic	3 Feedlot	6 Oil field water supply	9 Dewatering	12 Other (Specify below)
2 Irrigation	4 Industrial	7 Lawn and garden only	10 Observation well	

Was a chemical/bacteriological sample submitted to Department? Yes _____ No X; If yes, mo/day/yr sample was submitted _____

Water Well Disinfected? Yes X No _____

5 TYPE OF BLANK CASING USED:		5 Wrought iron	8 Concrete tile	CASING JOINTS: Glued <input checked="" type="checkbox"/> Clamped <input type="checkbox"/>	
1 Steel	3 RMP (SR)	6 Asbestos-Cement	9 Other (specify below)	Welded <input type="checkbox"/>	
2 PVC	4 ABS	7 Fiberglass		Threaded <input type="checkbox"/>	
Blank casing diameter	in. to	ft. Dia.	in. to	ft. Dia.	in. to

Blank casing diameter . . . 6 . . . in. to . . . ft., Dia . . . in. to . . . ft., Dia . . . in. to . . . ft.
Casing height above land surface . . . 12 . . . in., weight . . . 3.25 . . . lbs./ft. Wall thickness or gauge No. 160

TYPE OF SCREEN OR PERFORATION MATERIAL:

1 Steel	3 Stainless steel	5 Fiberglass	7 <u>PVC</u>	10 Asbestos-cement
2 Brass	4 Galvanized steel	6 Concrete tile	8 RMP (SR)	11 Other (specify)
			9 ABS	12 None used (open hole)

SCREEN OR PERFORATION OPENINGS ARE:

1 Continuous slot	3 Mill slot	5 Gauzed wrapped	8 Saw cut	11 None (open hole)
2 Louvered shutter	4 Key punched	6 Wire wrapped	9 Drilled holes	
		7 Torch cut	10 Other (specify)	

SCREEN-PERFORATED INTERVALS: From 34 ft. to 44 ft. From ft. to ft. From ft. to ft. From ft. to ft.

GRAVEL PACK INTERVALS: From ft. to ft. From ft. to ft. From ft. to ft. From ft. to ft.

6 GROUT MATERIAL: 1 Neat cement 2 Cement grout 3 Bentonite 4 Other

Grout Intervals: From 4 ft to 15 ft From ft to ft From ft to ft From ft to ft

What is the nearest source of possible contamination:

1 Septic tank	4 Lateral lines	7 Pit privy	10 Livestock pens	14 Abandoned water well
2 Sewer lines	5 Cess pool	8 Sewage lagoon	11 Fuel storage	15 Oil well/Gas well
3 Watertight sewer lines	6 Seepage pit	9 Feedyard	12 Fertilizer storage	16 Other (specify below)
Direction from well? SOUTH			13 Insecticide storage	
			How many feet? 60	

[illegible]

7 CONTRACTOR'S OR LANDOWNER'S CERTIFICATION: This water well was (1) constructed, (2) reconstructed, or (3) plugged under my jurisdiction and was completed on (mo/day/year) 8/31/82 and this record is true to the best of my knowledge and belief. Kansas Water Well Contractor's License No. 431 This Water Well Record was completed on (mo/day/yr) 9-25-83 under the business name of MILLER WATER WELL by (signature) Alan Miller

INSTRUCTIONS: Use typewriter or ball point pen, PLEASE PRESS FIRMLY and PRINT clearly. Please fill in blanks, underline or circle the correct answers. Send top three copies to Kansas Department of Health and Environment, Division of Environment, Environmental Geology Section, Topeka, KS 66620. Send one to WATER WELL OWNER and retain one for your records.