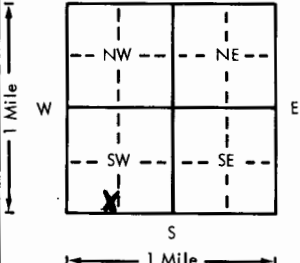


USE TYPEWRITER OR BALL
POINT PEN-PRESS FIRMLY,
PRINT CLEARLY.

WATER WELL RECORD
KSA 82a-1201-1215

Kansas Department of Health and
Environment-Division of Environment
(Water well Contractors)
Topeka, Kansas 66620

1. Location of well:	County Reno	Fraction SE 1/4 SW 1/4 SW 1/4	Section number 23	Township number T 23 S	Range number R 6 W E/W
2. Distance and direction from nearest town or city: 1/2 m W of Hutchinson, Ks.			3. Owner of well: John Ditmars R.R. or street: Rt. 1 City, state, zip code: Nickerson, Ks. 67561		
4. Locate with "X" in section below: <div style="text-align: center;">  </div>			Sketch map:		
5. Type and color of material			6. Bore hole dia. <u>10</u> in. Completion date <u>8/27/76</u> Well depth <u>42</u> ft.		
			7. <input checked="" type="checkbox"/> Cable tool <input checked="" type="checkbox"/> Rotary <input type="checkbox"/> Driven <input type="checkbox"/> Dug <input type="checkbox"/> Hollow rod <input type="checkbox"/> Jetted <input type="checkbox"/> Bored <input type="checkbox"/> Reverse rotary		
			8. Use: <input checked="" type="checkbox"/> Domestic <input type="checkbox"/> Public supply <input type="checkbox"/> Industry <input type="checkbox"/> Irrigation <input type="checkbox"/> Air conditioning <input type="checkbox"/> Stock <input type="checkbox"/> Lawn <input type="checkbox"/> Oil field water <input type="checkbox"/> Other		
			9. Casing: Material <u>plst</u> Height: Above or below Threaded <input type="checkbox"/> Welded <input type="checkbox"/> Surface <u>12</u> in. RMP <input checked="" type="checkbox"/> PVC <input type="checkbox"/> Weight <u>1.95</u> lbs./ft. Dia. <u>6</u> in. to <u>42</u> ft. depth Wall Thickness: inches or Dia. <u> </u> in. to <u> </u> ft. depth gage No. <u>200</u>		
			10. Screen: Manufacturer's name <u>J&L</u> Type <u>RMP</u> Dia. <u>6"</u> Slot/gauze <u>3/32</u> Length <u>10"</u> Set between <u>32</u> ft. and <u>42</u> ft. <u> </u> ft. and <u> </u> ft. Gravel pack? <u>yes</u> Size range of material <u>f-1/2"</u>		
(Use a second sheet if needed)			11. Static water level: <u>20</u> ft. below land surface Date <u>8/27/76</u> mo./day/yr.		
			12. Pumping level below land surfaces: <u>21</u> ft. after <u>1</u> hrs. pumping <u>20</u> g.p.m. <u> </u> ft. after <u> </u> hrs. pumping <u> </u> g.p.m. Estimated maximum yield <u>50</u> g.p.m.		
			13. Water sample submitted: <u> </u> mo./day/yr. <u> </u> Yes <input checked="" type="checkbox"/> No Date <u> </u>		
			14. Well head completion: <input checked="" type="checkbox"/> Pitless adapter <u>12</u> Inches above grade		
			15. Well grouted? <u>yes</u> With: <u> </u> Neat cement <u> </u> Bentonite <input checked="" type="checkbox"/> Concrete Depth: From <u>4</u> ft. to <u>14</u> ft.		
(Use a second sheet if needed)			16. Nearest source of possible contamination: <u>sewer line</u> ft. <u>15</u> Direction <u>E</u> Type <u> </u> Well disinfected upon completion? <input checked="" type="checkbox"/> Yes <input type="checkbox"/> No		
			17. Pump: <input checked="" type="checkbox"/> Not installed Manufacturer's name <u> </u> Model number <u> </u> HP <u> </u> Volts <u> </u> Length of drop pipe <u> </u> ft. capacity <u> </u> g.p.m. Type: <u> </u> Submersible <u> </u> Turbine <u> </u> Jet <u> </u> Reciprocating <u> </u> Centrifugal <u> </u> Other		
			20. Water well contractor's certification: This well was drilled under my jurisdiction and this report is true to the best of my knowledge and belief. Miller Water Well Serv. 137 Business name License No. <u> </u> Address <u>Hutchinson, Ks.</u> Signed <u>Joe Miller</u> Date <u>12/22/76</u> Authorized representative		
			18. Elevation:		
			19. Remarks:		

23
 6
 23
 SE
 SW
 SW
 Sec
 1/4
 1/4
 1/4