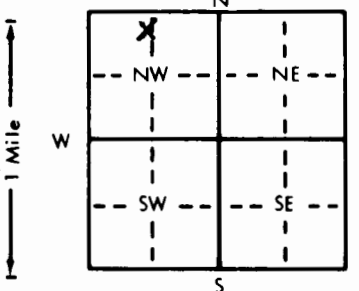


1 LOCATION OF WATER WELL:		Fraction	Section Number		Township Number	Range Number
County: <u>Reno</u>		<u>NE</u> $\frac{1}{4}$ <u>NW</u> $\frac{1}{4}$ <u>NW</u> $\frac{1}{4}$	<u>23</u>		<u>T</u> <u>23</u> <u>S</u>	<u>R</u> <u>6</u> <u>EW</u>
Distance and direction from nearest town or city street address of well if located within city? <u>500 ft Northwest of 1000 Morton Road, South Hutchinson, KS</u>						
2 WATER WELL OWNER: <u>Morton International, Inc.</u>						
RR#, St. Address, Box # : <u>1000 Morton Road, P.O. Box 1547</u>				Board of Agriculture, Division of Water Resources		
City, State, ZIP Code : <u>So. Hutchinson, KS 67504</u>				Application Number:		
3 LOCATE WELL'S LOCATION WITH AN "X" IN SECTION BOX:		4 DEPTH OF COMPLETED WELL: ft. ELEVATION:				
		Depth(s) Groundwater Encountered 1. ft. 2. ft. 3. ft.				
		WELL'S STATIC WATER LEVEL ft. below land surface measured on mo/day/yr				
		Pump test data: Well water was ft. after hours pumping gpm				
		Est. Yield gpm: Well water was ft. after hours pumping gpm				
		Bore Hole Diameter in. to ft., and in. to ft.				
WELL WATER TO BE USED AS:		5 Public water supply 8 Air conditioning 11 Injection well				
1 Domestic 3 Feedlot 6 Oil field water supply 9 Dewatering 12 Other (Specify below)						
2 Irrigation 4 Industrial 7 Lawn and garden only 10 Monitoring well						
Was a chemical/bacteriological sample submitted to Department? Yes.....No.....; If yes, mo/day/yr sample was submitted						
Water Well Disinfected? Yes No						
5 TYPE OF BLANK CASING USED:						
1 Steel 3 RMP (SR)		5 Wrought iron 8 Concrete tile		CASING JOINTS: Glued Clamped		
2 PVC 4 ABS		6 Asbestos-Cement 9 Other (specify below)		Welded		
		7 Fiberglass		Threaded		
Blank casing diameter .. <u>12</u> in. to <u>20+</u> ft., Dia in. to ft., Dia in. to ft.						
Casing height above land surface <u>-12</u> in., weight lbs./ft. Wall thickness or gauge No. <u>2 inch</u>						
TYPE OF SCREEN OR PERFORATION MATERIAL:						
1 Steel 3 Stainless steel 5 Fiberglass 8 RMP (SR)		7 PVC 10 Asbestos-cement		11 Other (specify)		
2 Brass 4 Galvanized steel 6 Concrete tile 9 ABS				12 None used (open hole)		
SCREEN OR PERFORATION OPENINGS ARE:						
1 Continuous slot 3 Mill slot 5 Gauzed wrapped 8 Saw cut 11 None (open hole)						
2 Louvered shutter 4 Key punched 6 Wire wrapped 9 Drilled holes						
		7 Torch cut 10 Other (specify)				
SCREEN-PERFORATED INTERVALS: From ft. to ft., From ft. to ft.						
From ft. to ft., From ft. to ft.						
GRAVEL PACK INTERVALS: From ft. to ft., From ft. to ft.						
From ft. to ft., From ft. to ft.						
6 GROUT MATERIAL: 1 Neat cement 2 Cement grout 3 Bentonite 4 Other						
Grout Intervals: From <u>20</u> ft. to <u>3</u> ft., From ft. to ft., From ft. to ft.						
What is the nearest source of possible contamination:						
1 Septic tank 4 Lateral lines 7 Pit privy 10 Livestock pens 14 Abandoned water well						
2 Sewer lines 5 Cess pool 8 Sewage lagoon 11 Fuel storage 15 Oil well/Gas well						
3 Watertight sewer lines 6 Seepage pit 9 Feedyard 12 Fertilizer storage 16 Other (specify below)						
		13 Insecticide storage <u>Steel Brine Lines</u>				
Direction from well? <u>South</u>		How many feet? <u>80</u>				
FROM	TO	LITHOLOGIC LOG	FROM	TO	PLUGGING INTERVALS	
			<u>20</u>	<u>3</u>	<u>Cement Grout</u>	
			<u>3</u>	<u>0</u>	<u>Surface Soil</u>	
7 CONTRACTOR'S OR LANDOWNER'S CERTIFICATION: This water well was (1) constructed, (2) reconstructed, or (3) plugged under my jurisdiction and was completed on (mo/day/year) <u>7-30-92</u> and this record is true to the best of my knowledge and belief. Kansas						
Water Well Contractor's License No. This Water Well Record was completed on (mo/day/yr) <u>7/31/92</u>						
under the business name of <u>Morton Salt Co.</u> by (signature) <u>[Signature]</u>						
INSTRUCTIONS: Use typewriter or ball point pen. PLEASE PRESS FIRMLY and PRINT clearly. Please fill in blanks, underline or circle the correct answers. Send top three copies to Kansas Department of Health and Environment, Bureau of Water Protection, Topeka, Kansas 66620-7320. Telephone: 913-296-5514. Send one to WATER WELL OWNER and retain one for your records.						