


1 LOCATION OF WATER WELL:		Fraction	Section Number	Township Number	Range Number
County:	Reno	SW 1/4 NW 1/4 SW 1/4	24	T 23 S	R 6 E

Distance and direction from nearest town or city street address of well if located within city?
2 1/2 mi. W. 1/2 N of Burton - Worthington Rd

2 WATER WELL OWNER: Doyle King
RR#, St. Address, Box # : Rt 1, Box 257
City, State, ZIP Code : Burton, KS 67020

Board of Agriculture, Division of Water Resources
Application Number:

3 LOCATE WELL'S LOCATION WITH AN "X" IN SECTION BOX: 4 DEPTH OF COMPLETED WELL 30 ft. ELEVATION:

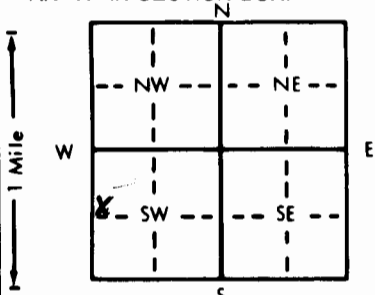

4 DEPTH OF COMPLETED WELL... 30 ft. ELEVATION:

Depth(s) Groundwater Encountered 1. ft. 2. ft. 3. ft.

WELL'S STATIC WATER LEVEL . . . 5 . . . ft. below land surface measured on mo/day/yr 5-29-87

Pump test data: Well water was 9 ft. after 1 1/2 hours pumping 25 gpm

Est. Yield gpm: Well water was . . . ft. after . . . hours pumping . . . gpm

Bore Hole Diameter . . . 8 . . . in. to 32 . . . ft., and . . . in. to . . . ft.

WELL WATER TO BE USED AS:

5 Public water supply	8 Air conditioning	11 Injection well		
1 Domestic	3 Feedlot	6 Oil field water supply	9 Dewatering	12 Other (Specify below)
2 Irrigation	4 Industrial	7 Lawn and garden only	10 Monitoring well	

Was a chemical/bacteriological sample submitted to Department? Yes. No. X If yes, mo/day/yr sample was submitted

Water Well Disinfected? Yes. X No.

5 TYPE OF BLANK CASING USED:		5 Wrought iron	8 Concrete tile	CASING JOINTS: Glued ☒ Clamped ☐
1 Steel	3 RMP (SR)	6 Asbestos-Cement	9 Other (specify below)	Welded ☐
2 PVC	4 ABS	7 Fiberglass		Threaded ☐

Blank casing diameter . . . 5 . . . in. to . . . 20 . . . ft. Dia . . . in. to . . . ft. Dia . . . in. to . . . ft.
Casing height above land surface . . . 12 . . . in. weight . . . 2.37 . . . lbs./ft. Wall thickness or gauge No. . . 160

TYPE OF SCREEN OR PERFORATION MATERIAL:			☒ PVC	10 Asbestos-cement
1 Steel	3 Stainless steel	5 Fiberglass	8 RMP (SR)	11 Other (specify)
2 Brass	4 Galvanized steel	6 Concrete tile	9 ABS	12 None used (open hole)

SCREEN OR PERFORATION OPENINGS ARE:		5 Gauzed wrapped	☒ Saw cut	11 None (open hole)
1 Continuous slot	3 Mill slot	6 Wire wrapped	9 Drilled holes	
2 Louvered shutter	4 Key punched	7 Torch cut	10 Other (specify)	

SCREEN-PERFORATED INTERVALS: From 20 ft. to 30 ft., From ft. to ft.
From ft. to ft., From ft. to ft.
GRAVEL PACK INTERVALS: From 15 ft. to 32 ft., From ft. to ft.
From ft. to ft., From ft. to ft.

6 GROUT MATERIAL: 1 Neat cement 2 Cement grout 3 Bentonite 4 Other
Grout Intervals: From 2 ft. to 15 ft. From ft. to ft. From ft. to ft.

What is the nearest source of possible contamination:

1 Septic tank	4 Lateral lines	7 Pit privy	10 Livestock pens	14 Abandoned water well
2 Sewer lines	5 Cess pool	8 Sewage lagoon	11 Fuel storage	15 Oil well/Gas well
3 Watertight sewer lines	6 Seepage pit	9 Feedyard	12 Fertilizer storage	16 Other (specify below)
Direction from well? <u>NE</u>			13 Insecticide storage	
			How many feet? <u>150</u>	

[illegible]

7 CONTRACTOR'S OR LANDOWNER'S CERTIFICATION: This water well was (1) constructed, (2) reconstructed, or (3) plugged under my jurisdiction and was completed on (mo/day/year) 5-29-93 and this record is true to the best of my knowledge and belief. Kansas Water Well Contractor's License No. 447 This Water Well Record was completed on (mo/day/yr) 6-4-93 under the business name of Miller Drilling by (signature) E. Miller