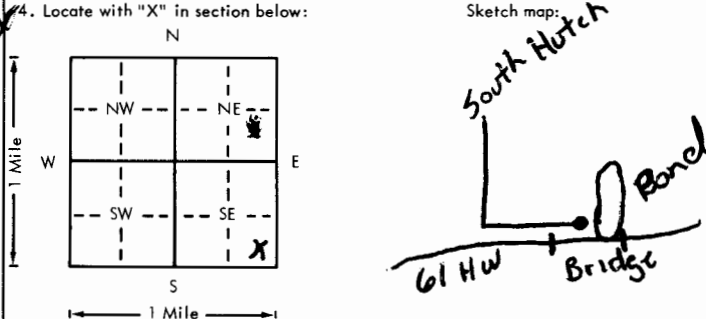


USE TYPEWRITER OR BALL
POINT PEN-PRESS FIRMLY,
PRINT CLEARLY.

WATER WELL RECORD
KSA 82a-1201-1215

Kansas Department of Health and
Environment-Division of Environment
(Water well Contractors)
Topeka, Kansas 66620

1. Location of well: Reno		Fraction: SE SE SE NE 1/4 NE 1/4 SE 1/4		Section number: 25		Township number: T 23		Range number: S R 6 E W	
2. Distance and direction from nearest town or city: 50 on rd HW from So Hutch 1st Rd before Street address of well location if in city: HW E 1 1/2 Block				3. Owner of well: Wilbeck Real Estate, Inc. R.R. or street: 25 East Williams City, state, zip code: South Hutchinson, Kansas 67505					
4. Locate with "X" in section below: 				6. Bore hole dia. 10 in. Completion date 10/27/78 Well depth 40 ft.					
5. Type and color of material				7. <input type="checkbox"/> Cable tool <input checked="" type="checkbox"/> Rotary <input type="checkbox"/> Driven <input type="checkbox"/> Dug <input type="checkbox"/> Hollow rod <input type="checkbox"/> Jetted <input type="checkbox"/> Bored <input type="checkbox"/> Reverse rotary					
				8. Use: <input type="checkbox"/> Domestic <input type="checkbox"/> Public supply <input checked="" type="checkbox"/> Industry <input type="checkbox"/> Irrigation <input type="checkbox"/> Air conditioning <input checked="" type="checkbox"/> Stock <input type="checkbox"/> Lawn <input type="checkbox"/> Oil field water <input type="checkbox"/> Other					
				9. Casing: Material Plastic Height: Above or below Threaded <input type="checkbox"/> Welded <input type="checkbox"/> Surface 18 in. RMP <input type="checkbox"/> PVC <input checked="" type="checkbox"/> Weight 160 lbs./ft. Dia. 6 in. to 20 ft. depth Wall thickness 3/8 inches or Dia. 2 in. to 20 ft. depth gage No. 38					
				10. Screen: Manufacturer's name Certain Tech sawed Type Sawed Dia. 6 Slot/gauze 1/4 Length 20 Set between 20 ft. and 40 ft. ft. and 40 ft. Gravel pack? <input checked="" type="checkbox"/> Size range of material 1/8 x 1/4					
				11. Static water level: 14' 8" ft. below land surface Date 10-27-78 mo./day/yr.					
				12. Pumping level below land surfaces: 18 ft. after 1 hrs. pumping 80 g.p.m. ft. after 1 hrs. pumping 80 g.p.m. Estimated maximum yield 100 g.p.m.					
				13. Water sample submitted: X No Date 10-27-78 Yes X No Date					
				14. Well head completion: 18 Inches above grade Pitless adapter					
				15. Well grouted? <input checked="" type="checkbox"/> With: <input type="checkbox"/> Neat cement <input type="checkbox"/> Bentonite <input checked="" type="checkbox"/> Concrete Depth: From 0 ft. to 10 ft.					
				16. Nearest source of possible contamination: ft. Direction none Type X No Well disinfected upon completion? Yes X No					
				17. Pump: <input checked="" type="checkbox"/> Not installed Manufacturer's name Model number 134 HP 1/4 Volts 115 Length of drop pipe 25 ft. capacity 25 g.p.m. Type: <input type="checkbox"/> Submersible <input type="checkbox"/> Turbine <input type="checkbox"/> Jet <input type="checkbox"/> Reciprocating <input type="checkbox"/> Centrifugal <input type="checkbox"/> Other					
				20. Water well contractor's certification: This well was drilled under my jurisdiction and this report is true to the best of my knowledge and belief. Rosencrantz-Bemis Ent. Inc. Business name License No. 134 Address 1211 W. 4th, Hutchinson, KS Signed Mike Flowers Date 6-9-79 Authorized representative					
				18. Elevation:					
				19. Remarks:					
				Topography: <input type="checkbox"/> Hill <input checked="" type="checkbox"/> Slope <input type="checkbox"/> Upland <input type="checkbox"/> Valley					

Forward the white, blue and pink copies to the Department of Health and Environment

Form WWC-5