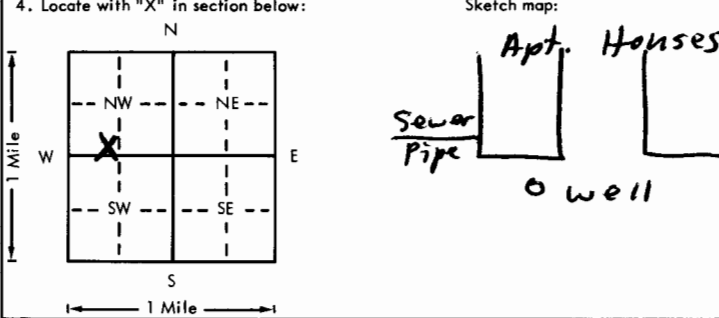


USE TYPEWRITER OR BALL
POINT PEN-PRESS FIRMLY,
PRINT CLEARLY.

WATER WELL RECORD
KSA 82a-1201-1215

Kansas Department of Health and
Environment-Division of Environment
(Water well Contractors)
Topeka, Kansas 66620

1. Location of well:		County Reno	Fraction SE 1/4 SW 1/4 NW 1/4	Section number 25	Township number T 23	Range number S R 6
2. Distance and direction from nearest town or city: Street address of well location if in city:		3. Owner of well: R.R. or street: City, state, zip code:		Jim Glass Jr. Const. Co. 20 E. Marshall South Hutchinson, Kan. 67501		
4. Locate with "X" in section below: Sketch map: 		6. Bore hole dia. 12 in. Completion date Well depth 33 ft. 5-7-76				
5. Type and color of material		From		To		7. <input type="checkbox"/> Cable tool <input type="checkbox"/> Rotary <input type="checkbox"/> Driven <input checked="" type="checkbox"/> Dug <input type="checkbox"/> Hollow rod <input type="checkbox"/> Jetted <input checked="" type="checkbox"/> Bored <input type="checkbox"/> Reverse rotary
Sandy soil		0		3		8. Use: <input type="checkbox"/> Domestic <input type="checkbox"/> Public supply <input type="checkbox"/> Industry <input type="checkbox"/> Irrigation <input type="checkbox"/> Air conditioning <input type="checkbox"/> Stock <input checked="" type="checkbox"/> Lawn <input type="checkbox"/> Oil field water <input type="checkbox"/> Other
brown sandy clay		3		7		9. Casing: Material Plas Height: Above or below Threaded <input type="checkbox"/> Welded Blue Surface 12 in. RMP <input type="checkbox"/> PVC <input checked="" type="checkbox"/> Weight <input type="checkbox"/> lbs./ft.
grey clay		7		9		Dia. 8 in. to 33 ft. depth Wall Thickness: inches or Dia. <input type="checkbox"/> in. to <input type="checkbox"/> ft. depth gage No. 1320
brown sandy clay		9		11		10. Screen: Manufacturer's name Jetstream
fine gravel		11		14		Type PVC Dia. 8" Slot/gauze 1/8 hole Length 12' Set between 21 ft. and 33 ft. Gravel pack? No Size range of material <input type="checkbox"/>
medium gravel		14		33		11. Static water level: <input type="checkbox"/> mo./day/yr. 10 ft. below land surface Date 5-7-76
						12. Pumping level below land surfaces: 10 1/2 ft. after 1 hrs. pumping 50 g.p.m. <input type="checkbox"/> ft. after <input type="checkbox"/> hrs. pumping <input type="checkbox"/> g.p.m. Estimated maximum yield 150 g.p.m.
						13. Water sample submitted: <input type="checkbox"/> Yes <input checked="" type="checkbox"/> No Date <input type="checkbox"/>
						14. Well head completion: <input type="checkbox"/> Pitless adapter 12 inches above grade
						15. Well grouted? yes With: <input type="checkbox"/> Neat cement <input type="checkbox"/> Bentonite <input checked="" type="checkbox"/> Concrete Depth: From 3 ft. to 11 ft.
						16. Nearest source of possible contamination: Solid 25 ft. Direction NW Type Sewer Well disinfected upon completion? <input type="checkbox"/> Yes <input checked="" type="checkbox"/> No
						17. Pump: <input checked="" type="checkbox"/> Not installed Manufacturer's name <input type="checkbox"/> Model number <input type="checkbox"/> HP <input type="checkbox"/> Volts <input type="checkbox"/> Length of drop pipe <input type="checkbox"/> ft. capacity <input type="checkbox"/> g.p.m. Type: <input type="checkbox"/> Submersible <input type="checkbox"/> Turbine <input type="checkbox"/> Jet <input type="checkbox"/> Reciprocating <input type="checkbox"/> Centrifugal <input type="checkbox"/> Other
18. Elevation:		19. Remarks:		20. Water well contractor's certification: This well was drilled under my jurisdiction and this report is true to the best of my knowledge and belief. Price Water Well 193 Business name RR3 Hutchinson License No. <input type="checkbox"/> Address John Dawengast Date 8-7-77 Signed <input type="checkbox"/> Authorized representative		

Forward the white, blue and pink copies to the Department of Health and Environment

Form WWC-5