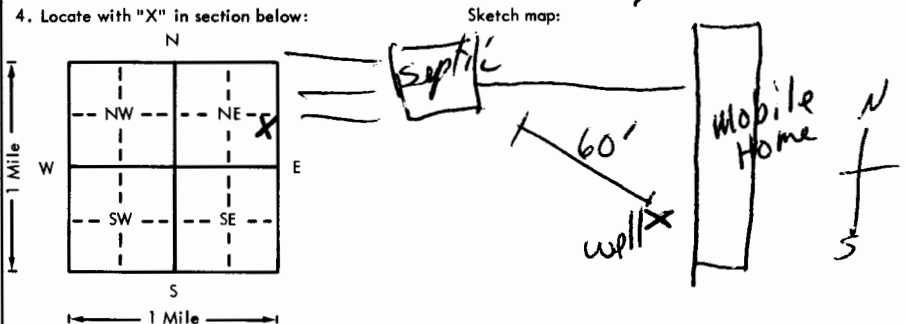


USE TYPEWRITER OR BALL  
POINT PEN-PRESS FIRMLY,  
PRINT CLEARLY.

WATER WELL RECORD  
KSA 82a-1201-1215

Kansas Department of Health and  
Environment-Division of Environment  
(Water well Contractors)  
Topeka, Kansas 66620

1. Location of well:		County <u>Reno</u>	Fraction <u>NE 1/4 SE 1/4 NE 1/4</u>	Section number <u>28</u>	Township number <u>23</u>	Range number <u>6</u>	EW
2. Distance and direction from nearest town or city: <u>2 W 1/2 mi S of</u>		3. Owner of well: <u>Ernest W. Durnall</u>					
Street address of well location if in city: <u>So. Hutchinson, Ks.</u>		R.R. or street: <u>R1</u>					
		City, state, zip code: <u>Hutchinson, Ks 67501</u>					
4. Locate with "X" in section below:		Sketch map:		6. Bore hole dia. <u>10</u> in. Completion date <u>4-19-76</u>			
				Well depth <u>47</u> ft.			
				7. Cable tool <input checked="" type="checkbox"/> Rotary <input type="checkbox"/> Driven <input type="checkbox"/> Dug <input type="checkbox"/> Hollow rod <input type="checkbox"/> Jetted <input type="checkbox"/> Bored <input type="checkbox"/> Reverse rotary			
				8. Use: <input checked="" type="checkbox"/> Domestic <input type="checkbox"/> Public supply <input type="checkbox"/> Industry <input type="checkbox"/> Irrigation <input type="checkbox"/> Air conditioning <input type="checkbox"/> Stock <input type="checkbox"/> Lawn <input type="checkbox"/> Oil field water <input type="checkbox"/> Other			
				9. Casing: Material <u>Plst</u> Height: <u>Above</u> or below Threaded <input type="checkbox"/> Welded <input type="checkbox"/> Surface <u>13</u> in. RMP <input checked="" type="checkbox"/> PVC <input type="checkbox"/> Weight <u>1.95</u> lbs./ft. Dia. <u>6</u> in. to <u>47</u> ft. depth Wall Thickness: inches or Dia. <u>6</u> in. to <u>47</u> ft. depth gage No. <u>200</u>			
5. Type and color of material		From		To		10. Screen: Manufacturer's name <u>J+L</u>	
<u>Topsoil</u>		<u>0</u>		<u>3</u>		Type <u>RMP</u> Dia. <u>6"</u>	
<u>Clay yellow</u>		<u>3</u>		<u>21</u>		Slot/gauze <u>3/32"</u> Length <u>10'</u>	
<u>Sand + gravel yellow</u>		<u>21</u>		<u>47</u>		Set between <u>37</u> ft. and <u>47</u> ft. ft. and <u>47</u> ft.	
						Gravel pack? <u>yes</u> Size range of material <u>F-5"</u>	
						11. Static water level: <u>28</u> ft. below land surface Date <u>4-23-76</u>	
						12. Pumping level below land surfaces: <u>33</u> ft. after <u>1</u> hrs. pumping <u>20</u> g.p.m. ft. after <u>   </u> hrs. pumping <u>   </u> g.p.m. Estimated maximum yield <u>30</u> g.p.m.	
						13. Water sample submitted: <u>   </u> mo./day/yr. <u>   </u> Yes <input checked="" type="checkbox"/> No <input type="checkbox"/> Date <u>   </u>	
						14. Well head completion: <u>   </u> Pitless adapter <u>12</u> inches above grade	
						15. Well grouted? <u>yes</u> With: <input checked="" type="checkbox"/> Neat cement <u>   </u> Bentonite <u>   </u> Concrete <u>   </u> Depth: From <u>0</u> ft. to <u>10</u> ft.	
						16. Nearest source of possible contamination: ft. <u>60</u> Direction <u>W</u> Type <u>septic</u> Well disinfected upon completion? <input checked="" type="checkbox"/> Yes <input type="checkbox"/> No	
						17. Pump: <input checked="" type="checkbox"/> Not installed Manufacturer's name <u>   </u> Model number <u>   </u> HP <u>   </u> Volts <u>   </u> Length of drop pipe <u>   </u> ft. capacity <u>   </u> g.p.m. Type: <u>   </u> Submersible <u>   </u> Turbine <u>   </u> Jet <u>   </u> Reciprocating <u>   </u> Centrifugal <u>   </u> Other	
						(Use a second sheet if needed)	
18. Elevation:		19. Remarks:		20. Water well contractor's certification: This well was drilled under my jurisdiction and this report is true to the best of my knowledge and belief. <u>Miller Water Well Serv. 137</u> Business name <u>Hutchinson, Ks.</u> License No. <u>   </u> Address <u>   </u> Signed <u>Joe Miller</u> Date <u>4-23-76</u> Authorized representative			
Topography: <u>   </u> Hill <u>   </u> Slope <input checked="" type="checkbox"/> Upland <u>   </u> Valley							

Forward the white, blue and pink copies to the Department of Health and Environment

Form WWC-5