


MW13

Well ID

[illegible]

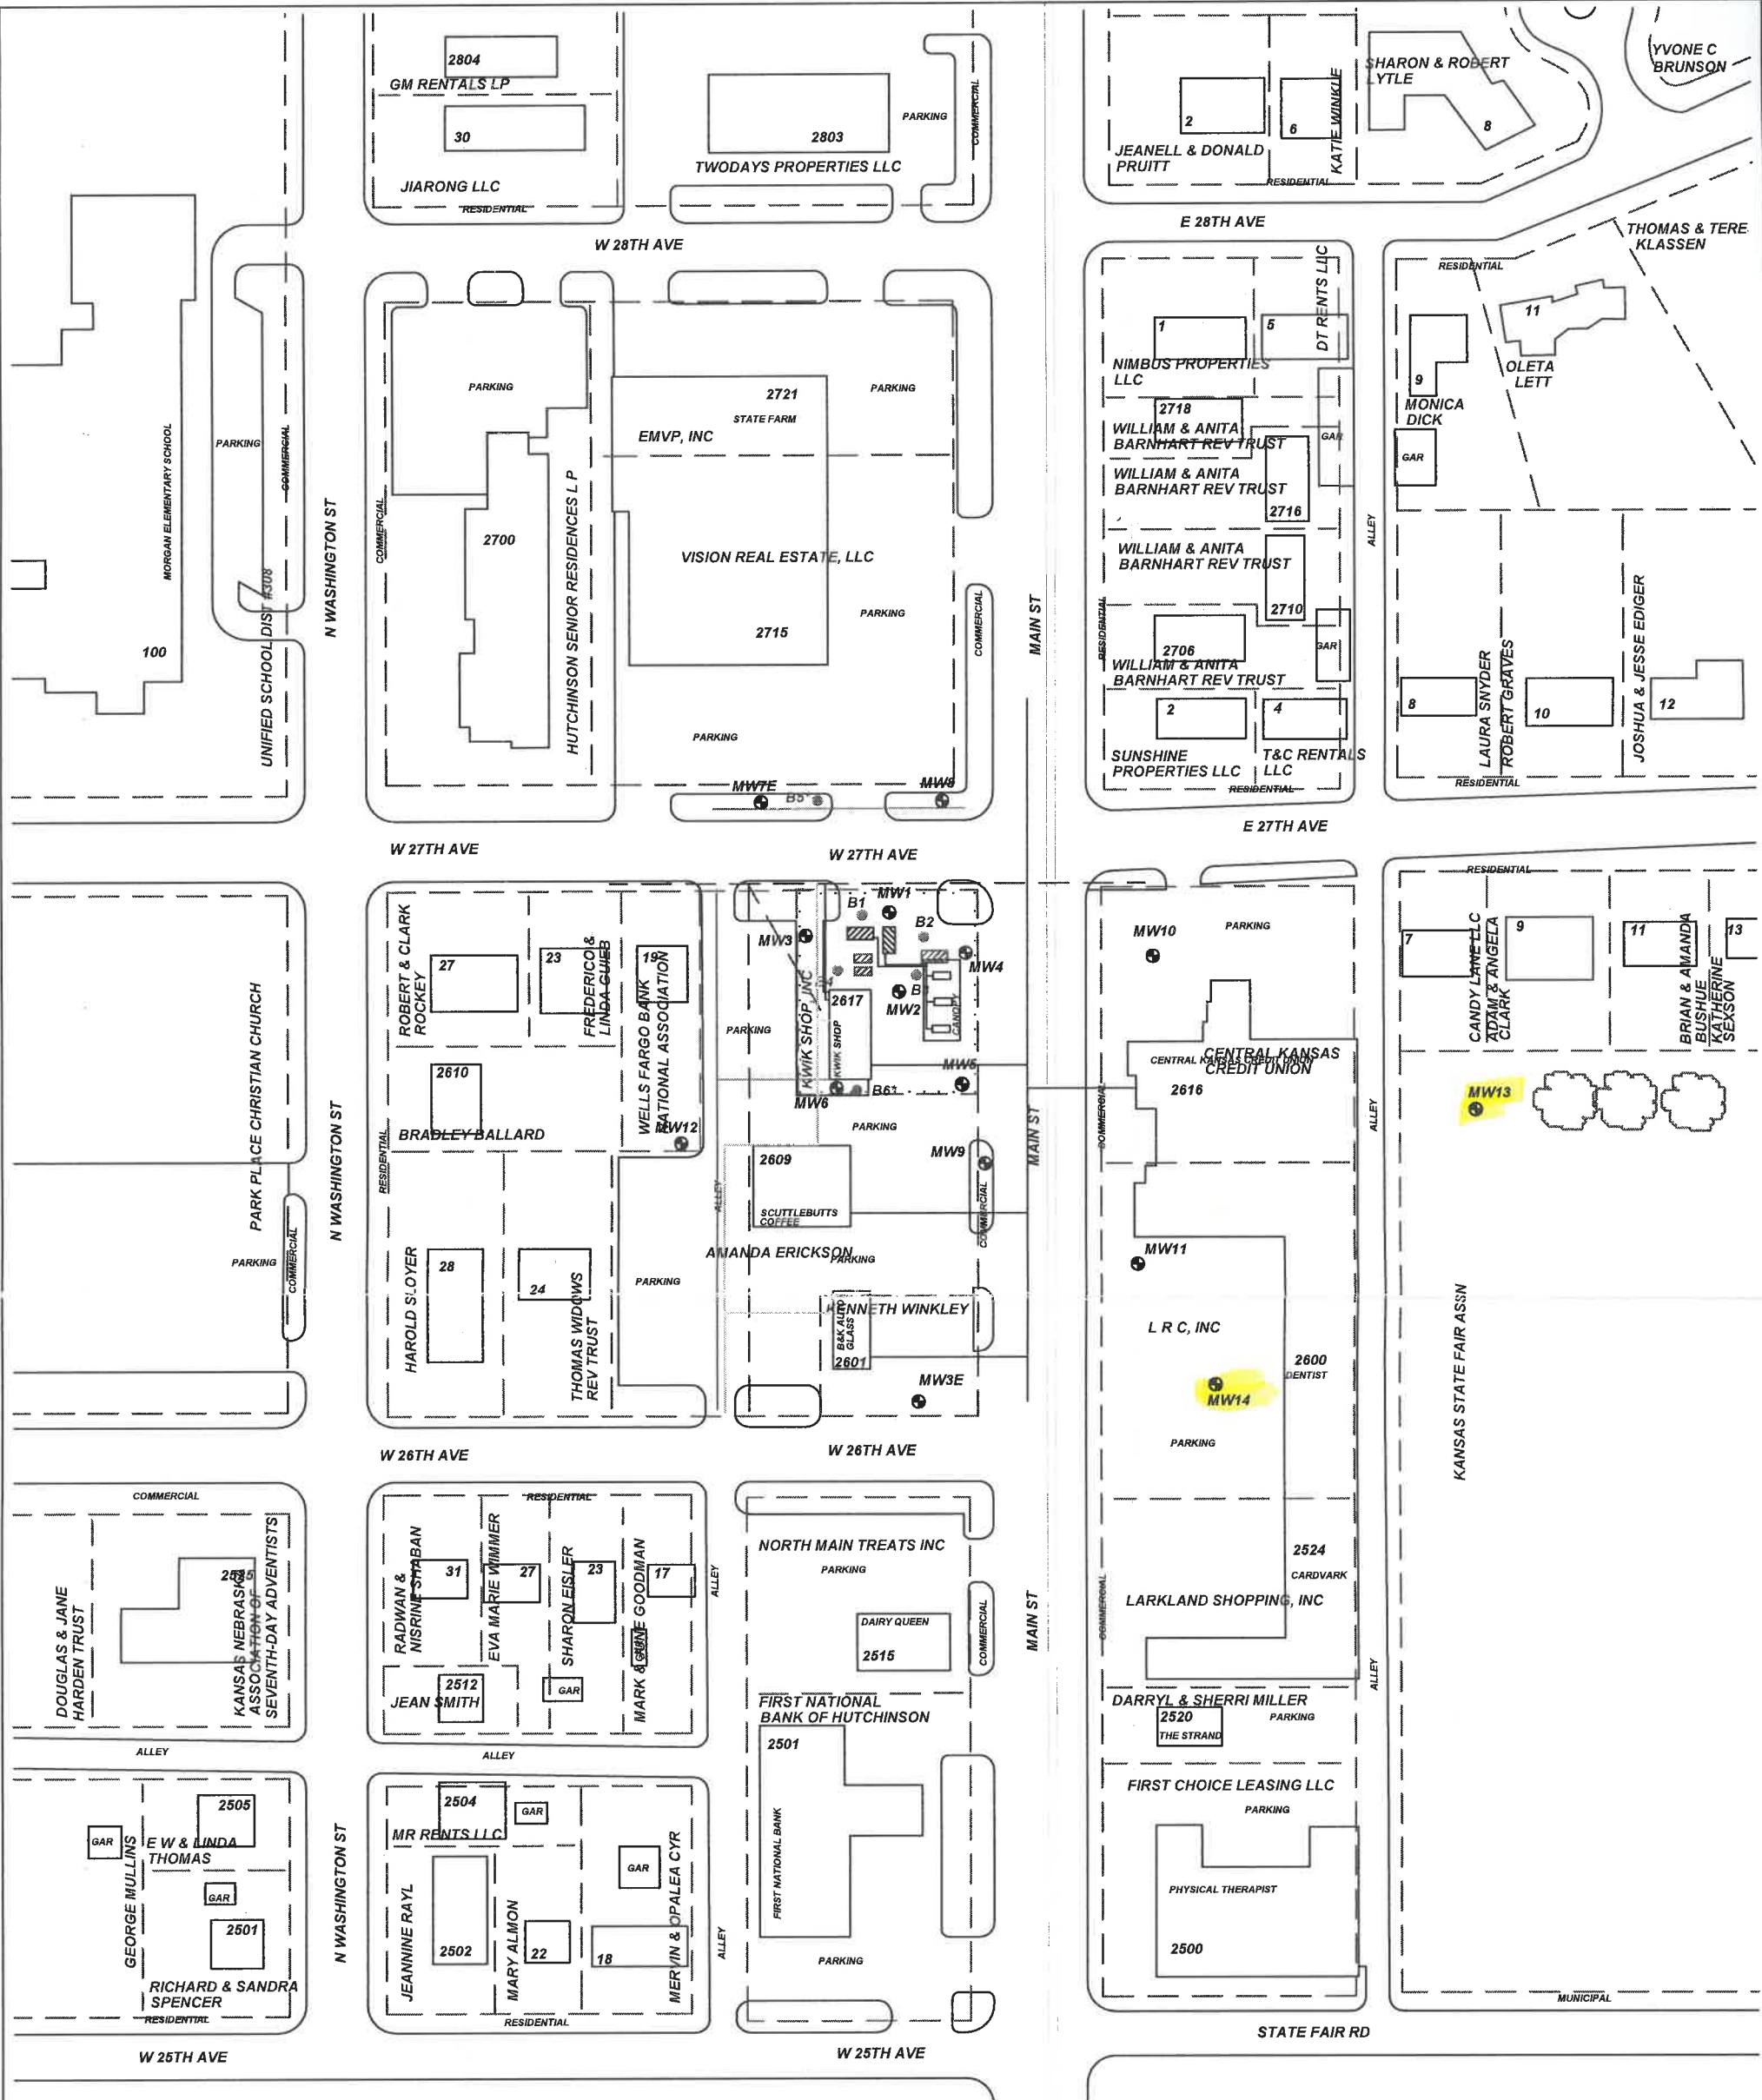

PROJECT: **KWIK SHOP #764**

ADDRESS: **2617 N. MAIN**

LOCATION: **HUTCHINSON, KS**

DRAWN BY: **B. STALNAKER** DATE: **5/17/18**

REVISED BY: **B. STALNAKER** DATE: **10/16/18**

AEI JOB #: **TF513** KDHE JOB #: **U2-078-15068**

TITLE: **FIGURE 2.3
AREA BASE MAP
500' RADIUS**

**ASSOCIATED
ENVIRONMENTAL
INC.**

SCALE: **1" = 100'**

0 50 100

NOTES: * = Indicates boring for unsaturated and saturated zone hydrologic data.
No basements observed within 500'.

LEGEND:

- = CURRENT BASIN AND PUMP ISLANDS/LINE
- = FORMER BASINS (FILLED IN PLACE)
- = MONITORING WELL
- = SOIL BORING
- = PROPOSED MONITORING WELL
- = SUBJECT PROPERTY
- = PARCEL BOUNDARY
- = OVERHEAD ELECTRIC (10-25')
- = BURIED ELECTRIC (2-5')
- = BURIED WATER (3-6')
- = BURIED GAS (2-4')
- = BURIED SEWER (2-12')
- = BURIED CABLE (2-5')

RECEIVED
JAN 21 2020
BUREAU OF WATER