WATER WELL RECORD Form WWC-5

☒ Original Record ☐ Correction ☐ Change in Well Use

Division of Water Resources App. No. ____ Well ID ____

1 LOCATION OF WATER WELL: County: Reno | Fraction: NW¼ SW¼ SE ¼ SE ¼ | Section Number: 20 | Township Number: T 23 S | Range Number: R 6 ☐ E ☒ W

2 WELL OWNER: Last Name: Tedder First: Jason
Business:
Address: 4310 West Blanchard
Address:
City: Hutchinson State: KS ZIP: 67501

Street or Rural Address where well is located (if unknown, distance and direction from nearest town or intersection): If at owner's address, check here: ☒
about 15 northwest of Shed, + 70 feet Northeast of center Shed

3 LOCATE WELL WITH "X" IN SECTION BOX:

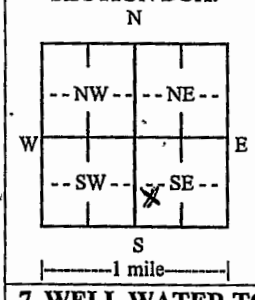

4 DEPTH OF COMPLETED WELL: 65 ft.
Depth(s) Groundwater Encountered: 1) ..... ft. 2) ..... ft. 3) ..... ft., or 4) ☐ Dry Well
WELL'S STATIC WATER LEVEL: 51 ft.
☐ below land surface, measured on (mo-day-yr).....
☐ above land surface, measured on (mo-day-yr).....
Pump test data: Well water was ..... ft. after..... hours pumping ..... gpm
Well water was ..... ft. after..... hours pumping ..... gpm
Estimated Yield: ..... gpm 25
Bore Hole Diameter: 10 5/8 in. to ..... ft. and ..... in. to ..... ft.

5 Latitude: 38.029231 (decimal degrees)
Longitude: -97.999397 (decimal degrees)
Horizontal Datum: ☒ WGS 84 ☐ NAD 83 ☐ NAD 27
Source for Latitude/Longitude:
☐ GPS (unit make/model: .....)
(WAAS enabled? ☐ Yes ☐ No)
☐ Land Survey ☐ Topographic Map
☐ Online Mapper: Google Earth Pro

6 Elevation: ..... ft. ☐ Ground Level ☐ TOC
Source: ☐ Land Survey ☐ GPS ☐ Topographic Map ☐ Other .....

7 WELL WATER TO BE USED AS:

1. Domestic: ☒ Household ☐ Lawn & Garden ☐ Livestock
2. ☐ Irrigation
3. ☐ Feedlot
4. ☐ Industrial
5. ☐ Public Water Supply: well ID .....
6. ☐ Dewatering: how many wells? .....
7. ☐ Aquifer Recharge: well ID .....
8. ☐ Monitoring: well ID .....
9. Environmental Remediation: well ID ..... ☐ Air Sparge ☐ Soil Vapor Extraction ☐ Recovery ☐ Injection
10. ☐ Oil Field Water Supply: lease .....
11. Test Hole: well ID ..... ☐ Cased ☐ Uncased ☐ Geotechnical
12. Geothermal: how many bores? ..... a) Closed Loop ☐ Horizontal ☐ Vertical b) Open Loop ☐ Surface Discharge ☐ Inj. of Water
13. ☐ Other (specify): .....

Was a chemical/bacteriological sample submitted to KDHE? ☐ Yes ☒ No If yes, date sample was submitted: .....
Water well disinfected? ☒ Yes ☐ No

8 TYPE OF CASING USED: ☐ Steel ☒ PVC ☐ Other ..... CASING JOINTS: ☒ Glued ☐ Clamped ☐ Welded ☐ Threaded
Casing diameter 5 in. to ..... ft., Diameter ..... in. to ..... ft., Diameter ..... in. to ..... ft.
Casing height above land surface ..... in. Weight ..... lbs./ft. Wall thickness or gauge No. .....
TYPE OF SCREEN OR PERFORATION MATERIAL:
☐ Steel ☐ Stainless Steel ☐ Fiberglass ☒ PVC ☐ Other (Specify) .....
☐ Brass ☐ Galvanized Steel ☐ Concrete tile ☐ None used (open hole)
SCREEN OR PERFORATION OPENINGS ARE:
☐ Continuous Slot ☒ Mill Slot ☐ Gauze Wrapped ☐ Torch Cut ☐ Drilled Holes ☐ Other (Specify) .....
☐ Louvered Shutter ☐ Key Punched ☐ Wire Wrapped ☐ Saw Cut ☐ None (Open Hole)
SCREEN-PERFORATED INTERVALS: From 45 ft. to 65 ft., From ..... ft. to ..... ft., From ..... ft. to ..... ft.
GRAVEL PACK INTERVALS: From 21 ft. to 45 ft., From ..... ft. to ..... ft., From ..... ft. to ..... ft.

9 GROUT MATERIAL: ☐ Neat cement ☐ Cement grout ☒ Bentonite ☐ Other .....
Grout Intervals: From 0 ft. to 21 ft., From ..... ft. to ..... ft., From ..... ft. to ..... ft.
Nearest source of possible contamination:
☐ Septic Tank ☐ Lateral Lines ☐ Pit Privy ☐ Livestock Pens ☐ Insecticide Storage
☐ Sewer Lines ☐ Cess Pool ☐ Sewage Lagoon ☐ Fuel Storage ☐ Abandoned Water Well
☐ Watertight Sewer Lines ☐ Seepage Pit ☐ Feedyard ☐ Fertilizer Storage ☐ Oil Well/Gas Well
☐ Other (Specify) .....
Direction from well? ..... Distance from well? ..... ft.

10 FROM	TO	LITHOLOGIC LOG	FROM	TO	LITHO. LOG (cont.) or PLUGGING INTERVALS
0	7	Tan Topsoil			
7	16	Tan Clay			
16	58	Fine Tan Sand			
58	65	Small Coarse Sand			

Notes:

11 CONTRACTOR'S OR LANDOWNER'S CERTIFICATION: This water well was ☒ constructed, ☐ reconstructed, or ☐ plugged under my jurisdiction and was completed on (mo-day-year) 3/17/22 and this record is true to the best of my knowledge and belief. Kansas Water Well Contractor's License No. 672 This Water Well Record was completed on (mo-day-year) 3/24/22 under the business name of Grandis Water Well Signature .....

Mail 1 white copy along with a fee of $5.00 for each constructed well to: Kansas Department of Health and Environment, Bureau of Water, GWTS Section, 1000 SW Jackson St, Suite 420, Topeka, Kansas 66612-1367. Mail one to Water Well Owner and retain one for your records. Telephone 785-296-5524.

Visit us at http://www.kdheks.gov/waterwell/index.html KSA 82a-1212 **Revised 7/10/2015**