

LOCATION OF WATER WELL	Fraction	Section Number	Township Number	Range Number			
County: <u>Reno</u>	<u>NE 1/4 SE 1/4 NE 1/4</u>	<u>1</u>	<u>T 23 S</u>	<u>R 9</u>			
Distance and direction from nearest town or city? <u>4 1/2 mi E, 3/4 mi N of Huntsville</u>		Street address of well if located within city? <u>NA</u>					
WATER WELL OWNER:							
PR#, St. Address, Box # : <u>KGS/GWMO #5</u>		Board of Agriculture, Division of Water Resources					
City, State, ZIP Code :		Application Number:					
DEPTH OF COMPLETED WELL: <u>125</u> ft. Bore Hole Diameter: <u>9 7/8</u> in. to <u>120</u> ft., and <u>6.0</u> in. to <u>125</u>							
Well Water to be used as:							
5 Public water supply		8 Air conditioning		11 Injection well			
1 Domestic 3 Feedlot		9 Dewatering		12 Other (Specify below)			
2 Irrigation 4 Industrial		10 Observation well		<u>Research</u>			
7 Lawn and garden only							
Well's static water level: <u>13.6</u> ft. below land surface measured on <u>Jan</u> month <u>29</u> day <u>1983</u> year							
Pump Test Data: <u>NA</u> Well water was <u> </u> ft. after <u> </u> hours pumping <u> </u> gpm							
Est. Yield <u> </u> gpm Well water was <u> </u> ft. after <u> </u> hours pumping <u> </u> gpm							
TYPE OF BLANK CASING USED:							
1 Steel		5 Wrought iron	8 Concrete tile	Casing Joints: <u>Glued</u> Clamped			
3 RMP (SR)		6 Asbestos-Cement	9 Other (specify below)	Welded			
<u>2 PVC</u>		7 Fiberglass		Threaded			
4 ABS							
Blank casing dia: <u>5.0</u> in. to <u>11.5</u> ft. Dia <u> </u> in. to <u> </u> ft. Dia <u> </u> in. to <u> </u> ft.							
Casing height above land surface: <u> </u> in., weight <u> </u> lbs./ft. Wall thickness or gauge No. <u>Schd #40</u>							
TYPE OF SCREEN OR PERFORATION MATERIAL:							
1 Steel		3 Stainless steel	5 Fiberglass	7 PVC			
2 Brass		4 Galvanized steel	6 Concrete tile	8 RMP (SR)			
				9 ABS			
				10 Asbestos-cement			
				11 Other (specify)			
				12 None used (open hole)			
Screen or Perforation Openings Are:							
1 Continuous slot		3 Mill slot	5 Gauzed wrapped	8 Saw cut			
2 Louvered shutter		4 Key punched	6 Wire wrapped	9 Drilled holes			
			7 Torch cut	10 Other (specify)			
				11 None (open hole)			
Screen-Perforation Dia: <u>5.0</u> in. to <u> </u> ft. Dia <u> </u> in. to <u> </u> ft. Dia <u> </u> in. to <u> </u> ft.							
Screen-Perforated Intervals: From <u>115</u> ft. to <u>120</u> ft. From <u> </u> ft. to <u> </u> ft. From <u> </u> ft. to <u> </u> ft.							
Gravel Pack Intervals: From <u>108</u> ft. to <u>120</u> ft. From <u> </u> ft. to <u> </u> ft. From <u> </u> ft. to <u> </u> ft.							
GROUT MATERIAL:							
1 Neat cement		2 Cement grout	3 Bentonite	4 Other			
Grouted Intervals: From <u>58</u> ft. to <u>108</u> ft. From <u>0</u> ft. to <u>120</u> ft. From <u> </u> ft. to <u> </u> ft.							
What is the nearest source of possible contamination: <u>NOT KNOWN</u>							
1 Septic tank		4 Cess pool	7 Sewage lagoon	10 Fuel storage			
2 Sewer lines		5 Seepage pit	8 Feed yard	11 Fertilizer storage			
3 Lateral lines		6 Pit privy	9 Livestock pens	12 Insecticide storage			
				13 Watertight sewer lines			
				14 Abandoned water well			
				15 Oil well/Gas well			
				16 Other (specify below)			
Direction from well: <u> </u> How many feet: <u> </u> Water Well Disinfected? Yes <u> </u> No <u> </u>							
Was a chemical/bacteriological sample submitted to Department? Yes <u> </u> No <u> </u> If yes, date sample was submitted: <u> </u> month <u> </u> day <u> </u> year: Pump Installed? Yes <u> </u> No <u> </u>							
If Yes: Pump Manufacturer's name: <u> </u> Model No. <u> </u> HP <u> </u> Volts <u> </u>							
Depth of Pump Intake: <u> </u> ft. Pumps Capacity rated at <u> </u> gal./min.							
Type of pump: 1 Submersible 2 Turbine 3 Jet 4 Centrifugal 5 Reciprocating 6 Other							
CONTRACTOR'S OR LANDOWNER'S CERTIFICATION: This water well was (1) constructed, (2) reconstructed, or (3) plugged under my jurisdiction and was completed on <u>Aug</u> <u>Sept</u> month <u>1</u> day <u>81</u> year <u> </u>							
and this record is true to the best of my knowledge and belief. Kansas Water Well Contractor's License No. <u> </u>							
This Water Well Record was completed on <u> </u> month <u> </u> day <u> </u> year under the business name of <u> </u> by (signature) <u> </u>							
LOCATE WELL'S LOCATION WITH AN "X" IN SECTION BOX:		FROM	TO	LITHOLOGIC LOG	FROM	TO	LITHOLOGIC LOG
		0	2	brown top soil			abbreviated log
		2	5	reddish brown sandy silt			
		5	53	clay, gray, varying amounts of sand in matrix			cored from 120-125
		53	96	sand, fine thru coarse, some gravel stringers and gray and red clay stringers, caliche zone @ 96			
		96	98/101	clay, red and gray sandy			
		98/101	125	red sandy siltstone			
ELEVATION: <u>1680.2</u>							
Depth(s) Groundwater Encountered 1. <u> </u> ft. 2. <u> </u> ft. 3. <u> </u> ft. 4. <u> </u> ft.					(Use a second sheet if needed)		
INSTRUCTIONS: Use typewriter or ball point pen, please press firmly and PRINT clearly. Please fill in blanks, underline or circle the correct answers. Send top three copies to Kansas Department of Health and Environment, Division of Environment, Water Well Contractors, Topeka, KS 66620. Send one to WATER WELL OWNER and retain one for your records.							

BIG BEND GMD#5-KGS
WATER QUALITY
OBSERVATION WELL
NETWORK

SITE NUMBER : 27
SITE LOCATION: NE NE NE


LEGAL LOCATION: 1-23-9W
COUNTY : RENO

WELL LOG

[illegible]


SITE NUMBER : 27
SITE LOCATION : NE SE NE
LEGAL LOCATION: SEC1 T23S R9W
COUNTY : RENO

LANDOWNER: DALE STUCKEY
ADDRESS : ABBYVILLE, KANSAS 67510
PHONE NO.: 316-286-5340

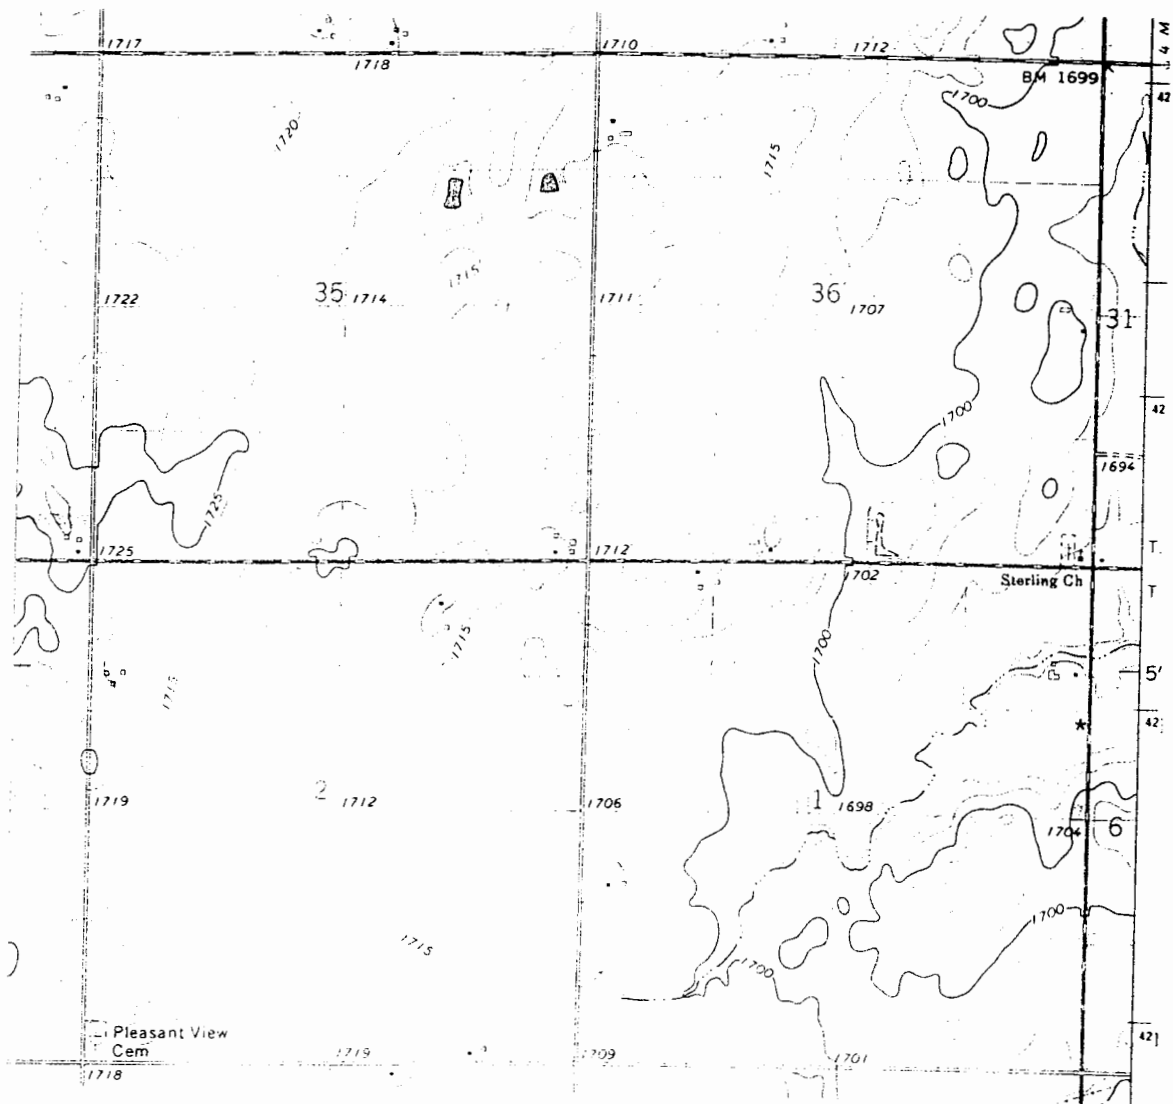

WELL LOCATION *

G. NE 1/4 Sec 1 T23S R9W RENO COUNTY

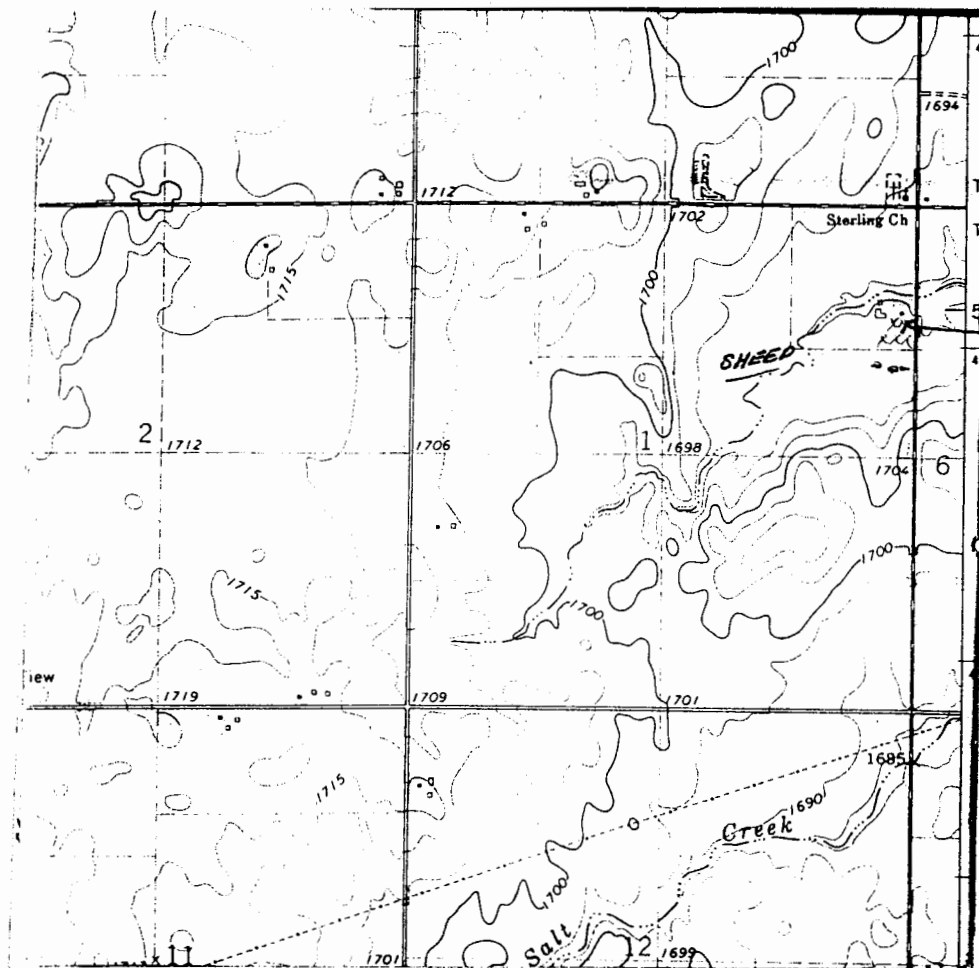

STUCKEY
RESIDENCE

#1-125
9-1-81
#2-65
8-27-81
#3-35
8-1-81

OWNER: DALE STUCKEY, Abbyville, Ks.
PH 1-286-5340

Permission given by owner on 7/27/81

★ Contact before drilling - owner will show
you where he wants the site installed
on NE 1/4. He will work with you to
select the site.