

Site #27-3

WATER WELL RECORD Form WWC-5 KSA 82a-1212

1. LOCATION OF WATER WELL		Fraction	Section Number	Township Number	Range Number
County: <u>Deer</u>		<u>NE 1/4 SE 1/4 NE 1/4</u>	<u>1</u>	<u>T 23 S</u>	<u>R 9 E</u>
Distance and direction from nearest town or city?			Street address of well if located within city?		


2. WATER WELL OWNER:		Board of Agriculture, Division of Water Resources
RR#, St. Address, Box #		Application Number:
City, State, ZIP Code		

3. DEPTH OF COMPLETED WELL: <u>35</u> ft. Bore Hole Diameter: <u>9 7/8</u> in. to		ft., and	in. to	
Well Water to be used as:		5 Public water supply	8 Air conditioning	11 Injection well
1 Domestic 3 Feedlot		6 Oil field water supply	9 Dewatering	12 Other (Specify below)
2 Irrigation 4 Industrial		7 Lawn and garden only	10 Observation well	<u>Research</u>
Well's static water level: <u>13.4</u> ft. below land surface measured on		<u>Jan</u> month	<u>29</u> day	<u>1983</u> year
Pump Test Data		Well water was	ft. after	hours pumping
Est. Yield		gpm: Well water was	ft. after	hours pumping

4. TYPE OF BLANK CASING USED:		5 Wrought iron	8 Concrete tile	Casing Joints: <u>Glued</u> Clamped
1 Steel 3 RMP (SR)		6 Asbestos-Cement	9 Other (specify below)	Welded
<u>2 PVC</u> 4 ABS		7 Fiberglass		Threaded
Blank casing dia: <u>5.0</u> in. to <u>30</u> ft. Dia		in. to	ft. Dia	in. to
Casing height above land surface		in., weight	lbs./ft. Wall thickness or gauge No. <u>Schd #40</u>	
TYPE OF SCREEN OR PERFORATION MATERIAL:		<u>7 PVC</u>	10 Asbestos-cement	
1 Steel 3 Stainless steel		5 Fiberglass	8 RMP (SR)	11 Other (specify)
2 Brass 4 Galvanized steel		6 Concrete tile	9 ABS	12 None used (open hole)
Screen or Perforation Openings Are:		5. Gauzed wrapped	8 Saw cut	11 None (open hole)
1 Continuous slot		6 Wire wrapped	9 Drilled holes	
2 Louvered shutter		7 Torch cut	10 Other (specify)	
Screen-Perforation Dia: <u>5.0</u> in. to		ft. Dia	in. to	ft. Dia
Screen-Perforated Intervals:		From: <u>30</u> ft. to <u>35</u> ft.	From: ft. to	From: ft. to
Gravel Pack Intervals:		From: <u>16</u> ft. to <u>35</u> ft.	From: ft. to	From: ft. to

5. GROUT MATERIAL:		<u>1 Neat cement</u>	2 Cement grout	3 Bentonite	4 Other		
Grouted Intervals: From: <u>14</u> ft. to <u>16</u> ft.		From: <u>0</u> ft. to <u>5</u> ft.	From: ft. to	From: ft. to			
What is the nearest source of possible contamination: <u>NONE KNOWN</u>							
1 Septic tank		4 Cess pool	7 Sewage lagoon	10 Fuel storage	14 Abandoned water well		
2 Sewer lines		5 Seepage pit	8 Feed yard	11 Fertilizer storage	15 Oil well/Gas well		
3 Lateral lines		6 Pit privy	9 Livestock pens	12 Insecticide storage	16 Other (specify below)		
Direction from well		How many feet	Water Well Disinfected? Yes	<u>No</u>			
Was a chemical/bacteriological sample submitted to Department? Yes		<u>No</u>	If yes, date sample				
was submitted		month	day	year	Pump Installed? Yes		
If Yes: Pump Manufacturer's name		Model No.	HP	Volts	<u>No</u>		
Depth of Pump Intake		ft.	Pumps Capacity rated at	gal./min			
Type of pump:		1 Submersible	2 Turbine	3 Jet	4 Centrifugal	5 Reciprocating	6 Other

6. CONTRACTOR'S OR LANDOWNER'S CERTIFICATION: This water well was (1) <u>constructed</u> , (2) reconstructed, or (3) plugged under my jurisdiction and was completed on <u>Sept</u> month <u>1</u> day <u>8</u> year <u>81</u>					
and this record is true to the best of my knowledge and belief. Kansas Water Well Contractor's License No.					
This Water Well Record was completed on					
name of					
by (signature)					

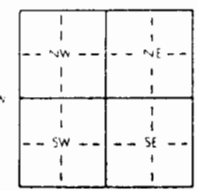7. LOCATE WELL'S LOCATION WITH AN "X" IN SECTION BOX:	FROM	TO	LITHOLOGIC LOG	FROM	TO	LITHOLOGIC LOG
						
ELEVATION: <u>1680.2</u>						

Depth(s) Groundwater Encountered 1. ft. 2. ft. 3. ft. 4. ft.				(Use a second sheet if needed)
--	--	--	--	--------------------------------

INSTRUCTIONS: Use typewriter or ball point pen, please press firmly and PRINT clearly. Please fill in blanks, underline or circle the correct answers. Send top three copies to Kansas Department of Health and Environment, Division of Environment, Water Well Contractors, Topeka, KS 66620. Send one to WATER WELL OWNER and retain one for your records.

BIG BEND GMD#5-KGS
WATER QUALITY
OBSERVATION WELL
NETWORK

SITE NUMBER : 27
SITE LOCATION: NE NE NE


LEGAL LOCATION: 1-23-9W
COUNTY : RENO

WELL LOG

[illegible]


SITE NUMBER : 27
SITE LOCATION : NE SE NE
LEGAL LOCATION: SEC1 T23S R9W
COUNTY : RENO

LANDOWNER: DALE STUCKEY
ADDRESS : ABBYVILLE, KANSAS 67510
PHONE NO.: 316-286-5340

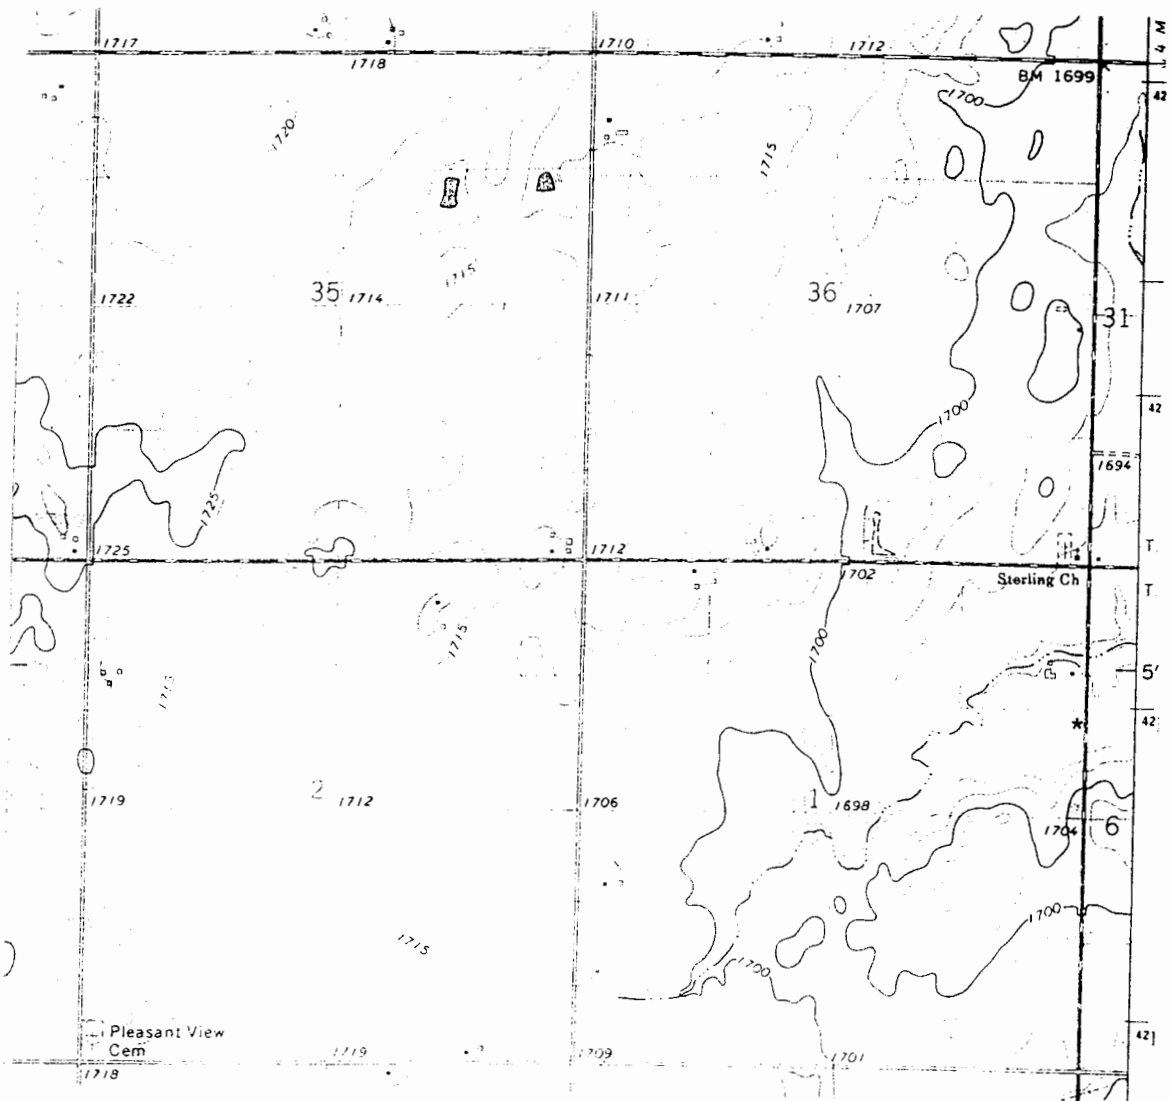

WELL LOCATION *

G. NE 1/4 Sec 1 T23S R9W RENO COUNTY

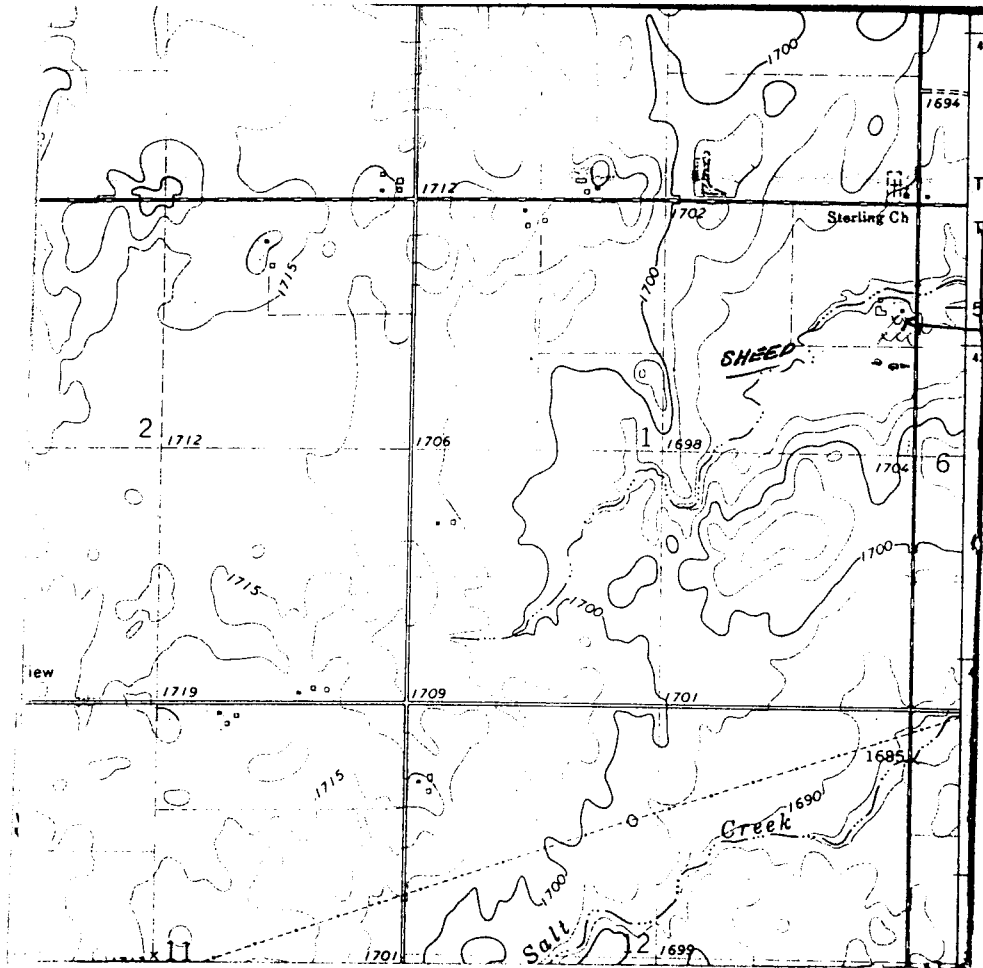

STUCKEY
RESIDENCE

#1-125

9-1-81

#2-65

8-27-81

#3-35

8-1-81

OWNER: DALE STUCKEY, Abbyville, Ks.
PH 1-286-5340

Permission given by owner on 7/29/81

★ Contact before drilling - owner will show you where he wants the site installed on NE 1/4. He will work with you to select the site.