


1 LOCATION OF WATER WELL: Harvey	FRACTION SW 1/4 NW 1/4 SE 1/4	Section Number 34	Township Number T 24 S	Range Number R 1W E/W
---	--	------------------------------------	---	--

Distance and direction from nearest town or city street address of well if located within city?

4th & Harrison (1/2 W. of Hoover on E. side of Harrison) Sedgwick, KS.

2 WATER WELL OWNER: CITY OF SEDGWICK	RR#, ST. ADDRESS, BOX #: 511 N. Commercial	Board of Agriculture, Division of Water Resource
CITY, STATE, ZIP CODE: Sedgwick, Kansas		Application Number: 960065

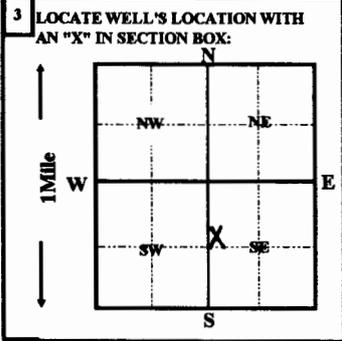

4 DEPTH OF COMPLETED WELL 50 ft. ELEVATION:

Depth(s) groundwater Encountered 1 ft. 2 ft. 3 ft.

WELL'S STATIC WATER LEVEL 14 FT. BELOW LAND SURFACE MEASURED ON 03/12/1996

Pump test data: Well water was _____ ft. after _____ hours pumping _____ gpm

Est. Yield _____ gpm: Well water was _____ ft. after _____ hours pumping _____ gpm

Bore Hole Diameter **12** in. to **50** ft. and _____ in. to _____ ft.

WELL WATER TO BE USED AS: 5 Public water supply 8 Air conditioning 11 Injection well

1 Domestic 3 Feedlot 6 Oil field water supply 9 Dewatering 12 Other (Specify below)

2 Irrigation 4 Industrial 7 Lawn and garden only 10 Monitoring well

Was a chemical/bacteriological sample submitted to Department? Yes _____ No ; If yes, mo/day/yr sample was submitted _____

Water Well Disinfected? Yes No _____

5 TYPE OF CASING USED:

1 Steel	3 RMP (SR)	5 Wrought iron	8 Concrete tile	CASING JOINTS:	Glued <input checked="" type="checkbox"/>	Clamped
2 PVC	4 ABS	6 Asbestos-Cement	9 Other (Specify below)		Welded	
Blank casing Diameter 8 in. to 25 ft., Dia _____ in. to _____ ft., Dia _____ in. to _____ ft.		7 Fiberglass	SDR-26		Threaded	
Casing height above land surface 12 in., weight 5.594 lbs. / ft.				Wall thickness or gauge No. .332		

TYPE OF SCREEN OR PERFORATION MATERIAL:

1 Steel	3 Stainless Steel	5 Fiberglass	8 RMP (SR)	11 other (specify)
2 Brass	4 Galvanized steel	6 Concrete tile	9 ABS	12 None used (open hole)

SCREEN OR PERFORATION OPENING ARE:

1 Continuous slot	3 Mill slot	5 Gauzed wrapped	8 Saw cut	11 None (open hole)
2 Louvered shutter	4 Key punched	6 Wire wrapped	9 Drilled holes	
		7 Torch cut	10 Other (specify)	

SCREEN-PERFORATION INTERVALS: from **25** ft. to **50** ft., From _____ ft. to _____ ft.

GRAVEL PACK INTERVALS: from _____ ft. to **24** ft., From **50** ft. to _____ ft.

6 GROUT MATERIAL: 1 Neat cement 2 Cement grout 3 Bentonite 4 Other **bentonite hole plug**

Grout Intervals: From **4** ft. to **24** ft. From _____ ft. to _____ ft.

What is the nearest source of possible contamination:

1 Septic tank	4 Lateral lines	7 Pit privy	10 Livestock pens	14 Abandon water well
2 Sewer lines	5 Cess pool	8 Sewage lagoon	11 Fuel storage	15 Oil well/Gas well
3 Watertight sewer lines	6 Seepage pit	9 Feedyard	12 Fertilizer storage	16 Other (specify below)
			13 Insecticide storage	None Apparent

Direction from well? _____ How many feet? _____

FROM	TO	LITHOLOGIC LOG	FROM	TO	PLUGGING INTERVALS
0	2	topsoil			
2	20	brown clay			
20	25	fine very silty sand			
25	30	fine to medium sand			
30	38	medium to coarse sand silty with several clay streaks			
38	50	blue shale			

7 CONTRACTOR'S OR LANDOWNER'S CERTIFICATION: This water well was (1) constructed, (2) reconstructed, or (3) plugged under my jurisdiction and was completed on (mo/day/year) 03/12/1996 and this record is true to the best of my knowledge and belief. Kansas Water Well Contractor's License No. 236 This Water Well Record was completed on (mo/day/yr) 03/28/96

Under the business name of Harp Well & Pump Service, Inc by (signature) Jane Frederick