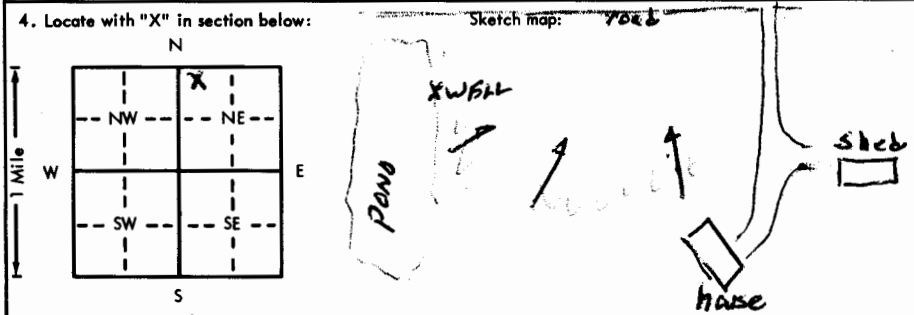


USE TYPEWRITER OR BALL  
POINT PEN-PRESS FIRMLY,  
PRINT CLEARLY.

WATER WELL RECORD  
KSA 82a-1201-1215

Kansas Department of Health and  
Environment-Division of Environment  
(Water well Contractors)  
Topeka, Kansas 66620

1. Location of well:	County <b>HARVEY</b>	Fraction <b>NW 1/4 NW 1/4 NE 1/4</b>	Section number <b>5</b>	Township number <b>T 24-S</b>	Range number <b>R 1 E/W</b>
2. Distance and direction from nearest town or city: Street address of well location if in city:	<b>2 1/2 EAST of HALSTEAD</b>		3. Owner of well: <b>REED ROBERTS</b> R.R. or street: <b>RR # 2</b> City, state, zip code: <b>HALSTEAD KANSAS 67056</b>		
4. Locate with "X" in section below:	Sketch map:		6. Bore hole dia. <b>4</b> in. Completion date <b>10/23/75</b> Well depth <b>78</b> ft.		
			7. <input checked="" type="checkbox"/> Cable tool <input checked="" type="checkbox"/> Rotary <input type="checkbox"/> Driven <input type="checkbox"/> Dug <input type="checkbox"/> Hollow rod <input type="checkbox"/> Jetted <input type="checkbox"/> Bored <input type="checkbox"/> Reverse rotary		
5. Type and color of material			8. Use: <input type="checkbox"/> Domestic <input type="checkbox"/> Public supply <input type="checkbox"/> Industry <input checked="" type="checkbox"/> Irrigation <input type="checkbox"/> Air conditioning <input type="checkbox"/> Stock <input type="checkbox"/> Lawn <input type="checkbox"/> Oil field water <input type="checkbox"/> Other		
			9. Casing: Material <b>PVC</b> Height: Above or below Threaded <input type="checkbox"/> Welded <input checked="" type="checkbox"/> Surface <b>2 1/2</b> in. RMP <input type="checkbox"/> PVC <input checked="" type="checkbox"/> Weight <b>2.55</b> lbs./ft. Dia. <b>5</b> in. to <b>78</b> ft. depth Wall Thickness: inches or Dia. <input type="checkbox"/> in. to <input type="checkbox"/> ft. depth gage No. <b>255</b>		
			10. Screen: Manufacturer's name <b>CREAT TOOL - OWN SLOT</b> Type <b>PVC</b> Dia. <b>5"</b> Slot/gauze <b>0468</b> Length <b>30'</b> Set between <b>38</b> ft. and <b>58</b> ft. <b>65</b> ft. and <b>75</b> ft. Gravel pack? <input checked="" type="checkbox"/> Size range of material <b>10-14</b>		
			11. Static water level: <b>24</b> ft. below land surface Date <b>10/23/75</b>		
			12. Pumping level below land surfaces: <b>26</b> ft. after <b>1</b> hrs. pumping <b>20</b> g.p.m. ft. after hrs. pumping g.p.m. Estimated maximum yield <b>150</b> g.p.m.		
			13. Water sample submitted: <b>Yes</b> <input checked="" type="checkbox"/> No <input type="checkbox"/> Date		
			14. Well head completion: <input type="checkbox"/> Pitless adapter <b>24</b> inches above grade		
			15. Well grouted? <b>YES</b> With: <input checked="" type="checkbox"/> Neat cement <input type="checkbox"/> Bentonite <input type="checkbox"/> Concrete Depth: From <b>18'</b> ft. to <b>0</b> ft.		
			16. Nearest source of possible contamination: <b>Pond</b> ft. <b>20'</b> Direction <b>WEST</b> Type <b>Surface</b> Well disinfected upon completion? <input type="checkbox"/> Yes <input checked="" type="checkbox"/> No		
			17. Pump: <input checked="" type="checkbox"/> Not installed Manufacturer's name Model number HP Volts Length of drop pipe ft. capacity g.p.m. Type: <input type="checkbox"/> Submersible <input type="checkbox"/> Turbine <input type="checkbox"/> Jet <input type="checkbox"/> Reciprocating <input type="checkbox"/> Centrifugal <input type="checkbox"/> Other		
			(Use a second sheet if needed)		
18. Elevation:	19. Remarks:		20. Water well contractor's certification: This well was drilled under my jurisdiction and this report is true to the best of my knowledge and belief. <b>PAUL'S INC #175</b> Business name License No. Address <b>400 N LANCASTER</b> Signed <b>Paul Bush</b> Date <b>10/23/75</b> Authorized representative		
Topography: <input type="checkbox"/> Hill <input type="checkbox"/> Slope <input checked="" type="checkbox"/> Upland <input type="checkbox"/> Valley					