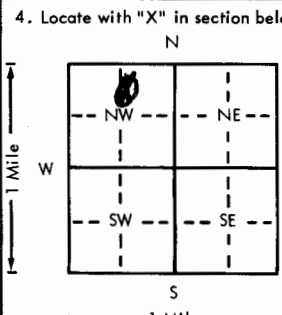



USE TYPEWRITER OR BALL
POINT PEN-PRESS FIRMLY,
PRINT CLEARLY.

WATER WELL RECORD
KSA 82a-1201-1215

Kansas Department of Health and
Environment-Division of Environment
(Water well Contractors)
Topeka, Kansas 66620

1. Location of well:	County HARVEY	Fraction NW 1/4 NE 1/4 NW 1/4	Section number 7	Township number T 24 S	Range number R 1 E
2. Distance and direction from nearest town or city:	1-South + 2 East of Holstead				
Street address of well location if in city:	of Holstead				
3. Owner of well:	Herman Becker				
R.R. or street:	RR #2				
City, state, zip code:	Halstead, KS				
4. Locate with "X" in section below:					
5. Type and color of material	From	To	6. Bore hole dia. 4 1/2 in. Completion date 11/18/78 Well depth 48 ft.		
LAM - DARK BROWN	0	5	7. <input checked="" type="checkbox"/> Cable tool <input checked="" type="checkbox"/> Rotary <input type="checkbox"/> Driven <input type="checkbox"/> Dug <input type="checkbox"/> Hollow rod <input type="checkbox"/> Jetted <input type="checkbox"/> Bored <input type="checkbox"/> Reverse rotary		
BROWN SILTY CLAY	5	13	8. Use: <input checked="" type="checkbox"/> Domestic <input type="checkbox"/> Public supply <input type="checkbox"/> Industry <input type="checkbox"/> Irrigation <input type="checkbox"/> Air conditioning <input type="checkbox"/> Stock <input type="checkbox"/> Lawn <input type="checkbox"/> Oil field water <input type="checkbox"/> Other		
BROWN (RUSTY) SAND med.	13	20	9. Casing: Material PLASTIC Height Above or below Threaded <input type="checkbox"/> Welded <input checked="" type="checkbox"/> Surface 18 in. RMP <input type="checkbox"/> PVC <input checked="" type="checkbox"/> Weight 2.87 lbs./ft. Dia. 5 in. to 48 ft. depth Wall Thickness: inches or Dia. <input type="checkbox"/> in. to <input type="checkbox"/> ft. depth Gauge No. 258		
COARSE SAND	20	26	10. Screen: Manufacturer's name KAM-Tech Type PLASTIC PIPE Slot/gauze 020 Length 10' Set between 48 ft. and 38 ft. ft. and <input type="checkbox"/> ft. Gravel pack? <input checked="" type="checkbox"/> Size range of material 1/2-1/4		
LIGHT BROWN CLAY	26	31	11. Static water level: <input type="checkbox"/> mg./day/yr. 26 ft. below land surface Date 11/18/78		
SAND - fine light brown	31	37	12. Pumping level below land surfaces: 29 ft. after 2 hrs. pumping 18 g.p.m. <input type="checkbox"/> ft. after <input type="checkbox"/> hrs. pumping <input type="checkbox"/> g.p.m. Estimated maximum yield 50-70 g.p.m.		
SAND - MED to coarse	37	46	13. Water sample submitted: <input type="checkbox"/> mo./day/yr. <input type="checkbox"/> Yes <input checked="" type="checkbox"/> No Date <input type="checkbox"/>		
LIGHT BROWN CLAY	46	48	14. Well head completion: <input checked="" type="checkbox"/> Pitless adapter 18 inches above grade		
			15. Well grouted? <input type="checkbox"/> With: <input checked="" type="checkbox"/> Neat cement <input type="checkbox"/> Bentonite <input type="checkbox"/> Concrete Depth: From 0 ft. to 10 ft.		
			16. Nearest source of possible contamination: house ft. 75 Direction West Type sewer Well disinfected upon completion? <input checked="" type="checkbox"/> Yes <input type="checkbox"/> No		
			17. Pump: <input type="checkbox"/> Not installed Manufacturer's name Dempster Model number AB63-SR-1/2 Volts 220 Length of drop pipe 40 ft. capacity 18 g.p.m. Type: <input checked="" type="checkbox"/> Submersible <input type="checkbox"/> Turbine <input type="checkbox"/> Jet <input type="checkbox"/> Reciprocating <input type="checkbox"/> Centrifugal <input type="checkbox"/> Other		
18. Elevation:	19. Remarks:		20. Water well contractor's certification: This well was drilled under my jurisdiction and this report is true to the best of my knowledge and belief. PAUL'S INC. #175 Business name HessTUN, KS License No. <input type="checkbox"/> Address Paul Bunlat Signed Paul Bunlat Date 11/18/78 Authorized representative		