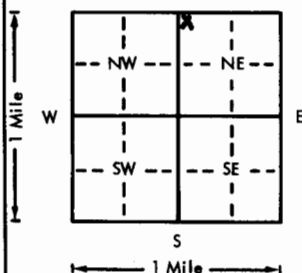


USE TYPEWRITER OR BALL
POINT PEN-PRESS FIRMLY,
PRINT CLEARLY.

WATER WELL RECORD
KSA 82a-1201-1215

Kansas Department of Health and
Environment-Division of Environment
(Water well Contractors)
Topeka, Kansas 66620

1. Location of well: <i>Blaney</i>		County <i>Blaney</i>	Fraction <i>NW 1/4 NW 1/4 NE 1/4</i>	Section number <i>8</i>	Township number <i>T 24</i>	Range number <i>S R 1 E W</i>
2. Distance and direction from nearest town or city: <i>4 N, 1 1/2 W of Sedgwick, KS</i>		3. Owner of well: <i>John A. Titus</i> R.R. or street: <i>Route 1</i> City, state, zip code: <i>Sedgwick, Kans.</i>				
4. Locate with "X" in section below: 		6. Bore hole dia. <i>11</i> in. Completion date Well depth <i>130</i> ft. <i>10-7-75</i>				
5. Type and color of material		From	To	7. <input checked="" type="checkbox"/> Cable tool <input checked="" type="checkbox"/> Rotary <input type="checkbox"/> Driven <input type="checkbox"/> Dug <input type="checkbox"/> Hollow rod <input type="checkbox"/> Jetted <input type="checkbox"/> Bored <input type="checkbox"/> Reverse rotary		
<i>Top sandy soil</i>		<i>0</i>	<i>3</i>	8. Use: <input checked="" type="checkbox"/> Domestic <input type="checkbox"/> Public supply <input type="checkbox"/> Industry <input type="checkbox"/> Irrigation <input type="checkbox"/> Air conditioning <input type="checkbox"/> Stock <input type="checkbox"/> Lawn <input type="checkbox"/> Oil field water <input type="checkbox"/> Other		
<i>clay</i>		<i>3</i>	<i>6</i>	9. Casing: Material <i>steel</i> Height above or below Threaded <input checked="" type="checkbox"/> Welded <input type="checkbox"/> Surface <i>12</i> in. RMP <input checked="" type="checkbox"/> PVC <input type="checkbox"/> Weight <i>5</i> lbs./ft. Dia. <i>5</i> in. to <i>130</i> ft. depth Wall Thickness: inches or Dia. <i>5</i> in. to <i>130</i> ft. depth gage No. <i>200</i>		
<i>Fine Red sand</i>		<i>6</i>	<i>30</i>	10. Screen: Manufacturer's name <i>Sunflower Plastic</i> Type <i>step</i> Dia. <i>5</i> " Slot/gauze <i>1.050</i> Length <i>10</i> ' Set between <i>120</i> ft. and <i>130</i> ft. Gravel pack <i>yes</i> Size range of material <i>1/4-1/8"</i>		
<i>clay</i>		<i>30</i>	<i>57</i>	11. Static water level: <i>35</i> ft. below land surface Date <i>10-7-75</i> mo./day/yr.		
<i>Fine sand with clay balls</i>		<i>57</i>	<i>80</i>	12. Pumping level below land surfaces: ____ ft. after ____ hrs. pumping ____ g.p.m. ____ ft. after ____ hrs. pumping ____ g.p.m. Estimated maximum yield ____ g.p.m.		
<i>clay</i>		<i>80</i>	<i>114</i>	13. Water sample submitted: ____ mo./day/yr. Yes ____ No ____ Date ____		
<i>Fine sand</i>		<i>114</i>	<i>130</i>	14. Well head completion: <i>capped</i> ____ Pitless adapter <i>12</i> inches above grade		
				15. Well grouted? <i>yes</i> With: ____ Neat cement ____ Bentonite <input checked="" type="checkbox"/> Concrete Depth: From <i>40</i> " to <i>14</i> ft.		
				16. Nearest source of possible contamination: <i>Septic Tank</i> ft. <i>80</i> Direction <i>NW</i> Type <i>Septic Tank</i> Well disinfected upon completion? <input checked="" type="checkbox"/> Yes ____ No ____		
				17. Pump: <input checked="" type="checkbox"/> Not installed Manufacturer's name ____ Model number ____ HP ____ Volts ____ Length of drop pipe ____ ft. capacity ____ g.p.m. Type: ____ Submersible ____ Turbine ____ Jet ____ Reciprocating ____ Centrifugal ____ Other ____		
18. Elevation:		19. Remarks:		20. Water well contractor's certification: This well was drilled under my jurisdiction and this report is true to the best of my knowledge and belief. <i>Harold Hill Pump 236</i> Business name <i>Wichita, Kans.</i> license No. ____ Address <i>Wichita, Kans.</i> Signed <i>Harold Hill</i> Date <i>10-9-75</i> Authorized representative		