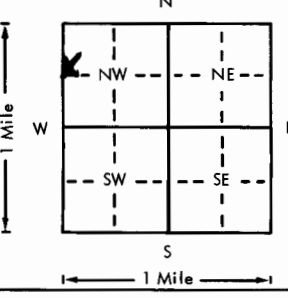
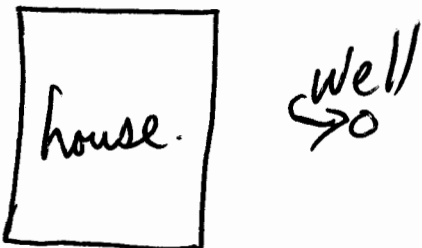


USE TYPEWRITER OR BALL  
POINT PEN-PRESS FIRMLY,  
PRINT CLEARLY.

WATER WELL RECORD  
KSA 82a-1201-1215

Kansas Department of Health and  
Environment-Division of Environment  
(Water well Contractors)  
Topeka, Kansas 66620

1. Location of well:	County <u>HARVEY.</u>	Fraction <u>SW 1/4 NW 1/4 NW 1/4</u>	Section number <u>9</u>	Township number <u>24</u>	Range number <u>1</u>
2. Distance and direction from nearest town or city: <u>5 No. 1 W, 1/4 So. Sedgwick</u> Street address of well location if in city:	3. Owner of well: <u>JOHN RYAN.</u> R.R. or street: <u>506 Lincoln</u> City, state, zip code: <u>Sedgwick KS 67135</u>				
4. Locate with "X" in section below:	Sketch map:			6. Bore hole dia. <u>7 1/2</u> in. Completion date <u>6/27/78</u> Well depth <u>76</u> ft.	
				7. <u>X</u> Cable tool <u>X</u> Rotary <u>  </u> Driven <u>  </u> Dug <u>  </u> Hollow rod <u>  </u> Jetted <u>  </u> Bored <u>  </u> Reverse rotary	
5. Type and color of material	From To			8. Use: <u>X</u> Domestic <u>  </u> Public supply <u>  </u> Industry <u>  </u> Irrigation <u>  </u> Air conditioning <u>  </u> Stock <u>  </u> Lawn <u>  </u> Oil field water <u>  </u> Other	
<u>Top Soil</u>	<u>0 2</u>			9. Casing: Material <u>Steel</u> Height: <u>0</u> above or below Threaded <u>  </u> Welded <u>X</u> Surface <u>1 1/2</u> in. RMP <u>X</u> PVC <u>  </u> Weight <u>11.50</u> lbs./ft. Dia. <u>5 1/2</u> in. to <u>26</u> ft. depth Wall Thickness: inches or Dia. <u>  </u> in. to <u>  </u> ft. depth Gage No. <u>200</u>	
<u>red clay.</u>	<u>2 18</u>			10. Screen: Manufacturer's name <u>Sumflower</u> Type <u>200</u> Dia. <u>5 1/2</u> Slot/gauze <u>1/16</u> Length <u>3 1/2</u> Set between <u>7 1/2</u> ft. and <u>30 1/2</u> ft. <u>  </u> ft. and <u>  </u> ft.	
<u>fine sugar sand.</u>	<u>18 48</u>			Gravel pack? <u>yes</u> Size range of material <u>3/8</u>	
<u>red clay.</u>	<u>48 56</u>			11. Static water level: <u>18</u> ft. below land surface Date <u>6/27/78</u>	
<u>fine sugar sand.</u>	<u>56 68</u>			12. Pumping level below land surfaces: <u>25</u> ft. after <u>12</u> hrs. pumping <u>15</u> g.p.m. <u>  </u> ft. after <u>  </u> hrs. pumping <u>  </u> g.p.m.	
<u>red clay.</u>	<u>68 70</u>			Estimated maximum yield <u>20-25</u> g.p.m.	
<u>med sand.</u>	<u>71 75</u>			13. Water sample submitted: <u>  </u> mo./day/yr. <u>  </u> Yes <u>X</u> No Date <u>  </u>	
<u>gray. red clay</u>	<u>75 76</u>			14. Well head completion: <u>  </u> Pitless adapter <u>12</u> inches above grade	
<u>also creek 90 ft. East.</u>			15. Well grouted? <u>yes</u> With: <u>  </u> Neat cement <u>  </u> Bentonite <u>X</u> Concrete Depth: From <u>3</u> ft. to <u>13</u> ft.		
			16. Nearest source of possible contamination: Type <u>150</u> Direction <u>SW</u> Type <u>Septic</u> Well disinfected upon completion? <u>X</u> Yes <u>  </u> No		
			17. Pump: <u>X</u> Not installed Manufacturer's name <u>  </u> Model number <u>  </u> HP <u>  </u> Volts <u>  </u> Length of drop pipe <u>  </u> ft. capacity <u>  </u> g.p.m. Type: <u>  </u> Submersible <u>  </u> Turbine <u>  </u> Jet <u>  </u> Reciprocating <u>  </u> Centrifugal <u>  </u> Other		
18. Elevation:	19. Remarks: <u>Customer to furnish 4'x4'x4' slab around well at grade</u> <u>Per State Regulations</u> <u>Signed X John Ryan</u>			20. Water well contractor's certification: This well was drilled under my jurisdiction and this report is true to the best of my knowledge and belief. <u>Wenger Thilly 318</u> Business name <u>Sedgwick KS</u> License No. <u>  </u> Address <u>  </u> Signed <u>Wenger</u> Date <u>6/27/78</u> Authorized representative	