

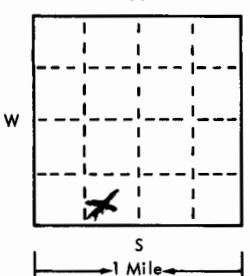
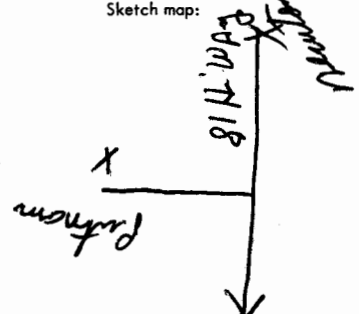
USE TYPEWRITER OR BALL
POINT PEN-PRESS FIRMLY,
PRINT CLEARLY.

WATER WELL RECORD
KSA 82a-1201-1215

T R EW sec 1/4 1/4 1/4 No.

Kansas State Dept. Of Health
(Water Well Contractors)
Forbes-Bldg. 740
Topeka, Kansas 66620

SWSE SW

1 Location of well:	County Harvey	Township name Sedgwick	Fraction SW 1/4	Section number 12	Town number 24	Range number 1N	
Distance and direction from nearest town or city: 4 mi South + 3 mi West of Newton, KS			3 Owner of well: W N Ward Address: R7D 3 Newton KS 67114				
Locate with "X" in section below: 			Sketch map: 			4 Well depth: 73 ft. Date of completion 8-3-75 Well diameter 10 in.	
2 Type and color of material			From	To	5 <input type="checkbox"/> Cable tool <input checked="" type="checkbox"/> Rotary <input type="checkbox"/> Driven <input type="checkbox"/> Dug <input type="checkbox"/> Hollow rod <input type="checkbox"/> Jetted <input type="checkbox"/> Bored <input type="checkbox"/> Reverse rotary		
			6 Use: <input checked="" type="checkbox"/> Domestic <input type="checkbox"/> Public supply <input type="checkbox"/> Industry <input type="checkbox"/> Irrigation <input type="checkbox"/> Air conditioning <input type="checkbox"/> Commercial <input type="checkbox"/> Test well				
			7 Casing: Material plastic Height: above/below Threaded <input type="checkbox"/> Welded <input type="checkbox"/> Surface 12 in. Diam. 5 in. to 53 ft. depth Drive shoe? <input type="checkbox"/> Yes <input checked="" type="checkbox"/> No Weight 1 1/2 lbs./ft.				
			8 Screen: 1 1/2 Manufacturer J & L Type 200 Dia. 5 in Slo gauge 116 Length 20 Set between 53 ft. and 73 ft. Fittings: Gravel pack <input checked="" type="checkbox"/> Yes <input type="checkbox"/> No Size range of material 5/8				
			9 Static water level: 18 ft. below land surface Date 8-3-75				
(use a second sheet if needed)			10 Pumping level below land surfaces: 40 ft. after 4 hrs. pumping 20 g.p.m. ____ ft. after ____ hrs. pumping ____ g.p.m. Estimated maximum yield ____ g.p.m.		11 Water sample submitted: <input checked="" type="checkbox"/> Yes <input type="checkbox"/> No Date 8-1-75		
			12 Well head completion: <input type="checkbox"/> Pitless adapter 18 inches above grade				
			13 Well grouted? <input checked="" type="checkbox"/> Yes <input type="checkbox"/> No <input checked="" type="checkbox"/> Neat cement <input type="checkbox"/> Bentonite <input type="checkbox"/> ____ Depth: From 10 ft. to 0 ft.				
			14 Nearest source of possible contamination: ft. 500 Direction East Type Septic Well disinfected upon completion? <input checked="" type="checkbox"/> Yes <input type="checkbox"/> No				
			15 Pump: <input checked="" type="checkbox"/> Not installed Manufacturer's name Red Jacket Model number ____ HP 1/2 Volts 230 Length of drop pipe ____ ft. capacity 15 g.m.p. Type: <input type="checkbox"/> Submersible <input type="checkbox"/> Turbine <input type="checkbox"/> Jet <input type="checkbox"/> Reciprocating <input type="checkbox"/> Centrifugal <input type="checkbox"/> Other				
16 Remarks: elevation Topography: <input type="checkbox"/> Hill <input type="checkbox"/> Slope <input type="checkbox"/> Upland <input checked="" type="checkbox"/> Valley			17 Water well contractor's certification: This well was drilled under my jurisdiction and this report is true to the best of my knowledge and belief. D & R Well Drmers 211 Business name License No. Address 406 Rancho RD Newton KS Signed Edith Williams Date 9-3-75 Authorized representative				