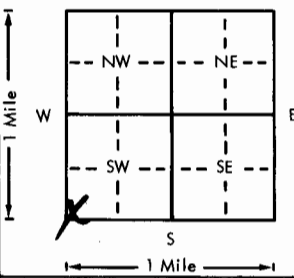
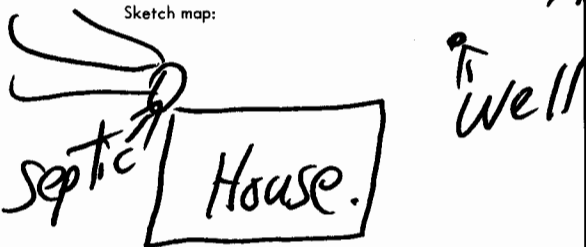


USE TYPEWRITER OR BALL
POINT PEN—PRESS FIRMLY,
PRINT CLEARLY.

WATER WELL RECORD
KSA 82a-1201-1215

Kansas Department of Health and
Environment—Division of Environment
(Water well Contractors)
Topeka, Kansas 66620

1. Location of well: County <u>HARVEY.</u> Fraction <u>SW 1/4 SW 1/4 SW 1/4</u> Section number <u>18</u> Township number <u>24</u> S R <u>1</u> E <u>W</u>	
2. Distance and direction from nearest town or city: <u>3.50 / E Harstead KS.</u>	
3. Owner of well: <u>John Alldritt</u> R.R. or street: <u>R#2</u> City, state, zip code: <u>Harstead KS 67056</u>	
4. Locate with "X" in section below:  Sketch map: 	
5. Type and color of material	
6. Bore hole dia. <u>5 1/2</u> in. Completion date <u>8/20/78</u> Well depth <u>57</u> ft.	
7. <input checked="" type="checkbox"/> Cable tool <input checked="" type="checkbox"/> Rotary <input type="checkbox"/> Driven <input type="checkbox"/> Dug <input type="checkbox"/> Hollow rod <input type="checkbox"/> Jetted <input type="checkbox"/> Bored <input type="checkbox"/> Reverse rotary	
8. Use: <input checked="" type="checkbox"/> Domestic <input type="checkbox"/> Public supply <input type="checkbox"/> Industry <input type="checkbox"/> Irrigation <input type="checkbox"/> Air conditioning <input type="checkbox"/> Stock <input type="checkbox"/> Lawn <input type="checkbox"/> Oil field water <input type="checkbox"/> Other	
9. Casing: Material <u>Steel</u> Height: <u>0</u> above or below Threaded <input checked="" type="checkbox"/> Welded <input type="checkbox"/> Surface <u>12</u> in. RMP <u>5</u> PVC <input type="checkbox"/> Weight <u>1.60</u> lbs./ft. Dia. <u>5</u> in. <u>57</u> ft. depth Wall Thickness: inches or Dia. <u>5</u> in. to <u>57</u> ft. depth gage No. <u>200</u>	
10. Screen: Manufacturer's name <u>Sunflower</u> Type <u>200</u> Dia. <u>5 1/2</u> in. Slot gauge <u>1/16</u> Length <u>8 1/2</u> ft. Set between <u>49</u> ft. and <u>57</u> ft. Gravel pack? <u>yes</u> size range of material <u>3/8</u>	
11. Static water level: <u>26</u> ft. below land surface Date <u>8/20/78</u> mo./day/yr.	
12. Pumping level below land surfaces: <u>30</u> ft. after <u>1/2</u> hrs. pumping <u>15</u> g.p.m. <u>49</u> ft. after <u>1</u> hrs. pumping <u>30</u> g.p.m. Estimated maximum yield <u>25-30</u> g.p.m.	
13. Water sample submitted: <u>Yes</u> <input checked="" type="checkbox"/> No <input type="checkbox"/> Date <u>8/20/78</u> mo./day/yr.	
14. Well head completion: <u>12</u> inches above grade <input type="checkbox"/> Pitless adapter	
15. Well grouted? <u>yes</u> With: <input type="checkbox"/> Neat cement <input type="checkbox"/> Bentonite <input checked="" type="checkbox"/> Concrete Depth: From <u>3</u> ft. to <u>13</u> ft.	
16. Nearest source of possible contamination: <u>100</u> ft. Direction <u>SW</u> Type <u>Septic</u> Well disinfected upon completion? <input checked="" type="checkbox"/> Yes <input type="checkbox"/> No	
17. Pump: <input checked="" type="checkbox"/> Not installed Manufacturer's name <u>Wenger</u> Model number <u>318</u> HP <u>1/2</u> Volts <u>115</u> Length of drop pipe <u>57</u> ft. capacity <u>30</u> g.p.m. Type: <input type="checkbox"/> Submersible <input type="checkbox"/> Turbine <input type="checkbox"/> Jet <input type="checkbox"/> Reciprocating <input type="checkbox"/> Centrifugal <input type="checkbox"/> Other	
18. Elevation: <u>1000</u>	
19. Remarks: <u>Customer to furnish 4'x4'x1' slab around casing at grade</u> <u>Per State Regulations</u> <u>Signed John H. Alldritt</u> <u>Wenger Pumps 318</u> <u>Address Lawrence KS</u> <u>Signed 8/20/78</u> <u>Authorized representative</u>	

24-10-18 SW SW SW
T R Sec
1/4 1/4 1/4