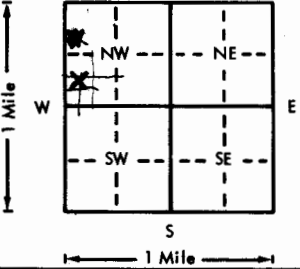


USE TYPEWRITER OR BALL  
POINT PEN-PRESS FIRMLY,  
PRINT CLEARLY.

WATER WELL RECORD  
KSA 82a-1201-1215

Kansas Department of Health and  
Environment-Division of Environment  
(Water well Contractors)  
Topeka, Kansas 66620

1. Location of well:		County <b>Harvey</b>	Fraction <b><del>SW</del> 1/4 <del>SW</del> 1/4 NW 1/4</b>	Section number <b>19</b>	Township number <b>T 24</b>	Range number <b>S R 1</b>	<b>EW</b>
2. Distance and direction from nearest town or city: <b>2W 2 3/4 N Sedgwick</b>				3. Owner of well: <b>Wayne Jacob</b> R.R. or street: <b>Sedgwick Kansas</b> City, state, zip code:			
4. Locate with "X" in section below:  N W E S 1 Mile				Sketch map: <b>open field</b>			
5. Type and color of material				From	To	6. Bore hole dia. <b>30</b> in. Completion date <b>4/7/76</b> Well depth <b>73</b> ft.	
<b>Topsoil</b>				<b>0</b>	<b>1</b>	7. <input type="checkbox"/> Cable tool <input type="checkbox"/> Rotary <input type="checkbox"/> Driven <input type="checkbox"/> Dug <input type="checkbox"/> Hollow rod <input type="checkbox"/> Jetted <input type="checkbox"/> Bored <input checked="" type="checkbox"/> Reverse rotary	
<b>Fine Sand</b>				<b>1</b>	<b>10</b>	8. Use: <input type="checkbox"/> Domestic <input type="checkbox"/> Public supply <input type="checkbox"/> Industry <input checked="" type="checkbox"/> Irrigation <input type="checkbox"/> Air conditioning <input type="checkbox"/> Stock <input type="checkbox"/> Lawn <input type="checkbox"/> Oil field water <input type="checkbox"/> Other	
<b>Sand / clay (gray)</b>				<b>10</b>	<b>27</b>	9. Casing: Material <b>Cem</b> Height: <b>Above</b> or below Threaded <input type="checkbox"/> Welded <input type="checkbox"/> Surface <b>12</b> in. RMP <input type="checkbox"/> PVC <input type="checkbox"/> Weight <input type="checkbox"/> lbs./ft. Dia. <b>16</b> in. to <b>73</b> ft. depth Wall Thickness: inches or Dia. <input type="checkbox"/> in. to <input type="checkbox"/> ft. depth Gauge No. <b>1 inch</b>	
<b>Gray clay - some rock - some gravel</b>				<b>27</b>	<b>50</b>	10. Screen: Manufacturer's name <b>Johnson Well Casing</b> Type <b>Cem-Asb</b> Dia. <b>16"</b> Slot/gauze <b>1/4"</b> Length <b>26'</b> Set between <b>47</b> ft. and <b>73</b> ft. <input type="checkbox"/> ft. and <input type="checkbox"/> ft. Gravel pack? <b>yes</b> Size range of material: <b>3/8</b>	
<b>Good Gravel</b>				<b>50</b>	<b>73</b>	11. Static water level: <input type="checkbox"/> mo./day/yr. <b>30</b> ft. below land surface Date <b>4/7/76</b>	
<b>Clay</b>				<b>73</b>	<b>95</b>	12. Pumping level below land surfaces: <b>40</b> ft. after <b>2</b> hrs. pumping <b>650</b> g.p.m. <input type="checkbox"/> ft. after <input type="checkbox"/> hrs. pumping <input type="checkbox"/> g.p.m. Estimated maximum yield <b>700</b> g.p.m.	
						13. Water sample submitted: <input type="checkbox"/> mo./day/yr. <input type="checkbox"/> Yes <input checked="" type="checkbox"/> No Date	
						14. Well head completion: <input type="checkbox"/> Pitless adapter <b>10</b> inches above grade	
						15. Well grouted? <b>yes</b> With: <input type="checkbox"/> Neat cement <input type="checkbox"/> Bentonite <input checked="" type="checkbox"/> Concrete Depth: From <b>0</b> ft. to <b>10</b> ft.	
						16. Nearest source of possible contamination: ft. <b>1600</b> Direction <b>North</b> Type <b>Domestic well</b> Well disinfected upon completion? <input type="checkbox"/> Yes <input checked="" type="checkbox"/> No	
						17. Pump: <input type="checkbox"/> Not installed Manufacturer's name <b>Peerless</b> Model number <b>5833</b> HP <input type="checkbox"/> Volts <input type="checkbox"/> Length of drop pipe <b>60</b> ft. capacity <b>700</b> g.p.m. Type: <input type="checkbox"/> Submersible <input checked="" type="checkbox"/> Turbine <input type="checkbox"/> Jet <input type="checkbox"/> Reciprocating <input type="checkbox"/> Centrifugal <input type="checkbox"/> Other	
(Use a second sheet if needed)							
18. Elevation:		19. Remarks:		20. Water well contractor's certification: This well was drilled under my jurisdiction and this report is true to the best of my knowledge and belief. <b>Weninger Irrigation 238</b> Business name <b>Maize, Kansas</b> License No. Address <b>K. Weninger</b> Date <b>May 10, 1976</b> Signed <b>K. Weninger</b> Authorized representative			

247-1-29  
1/4 SW 1/4 NW  
10/1/76