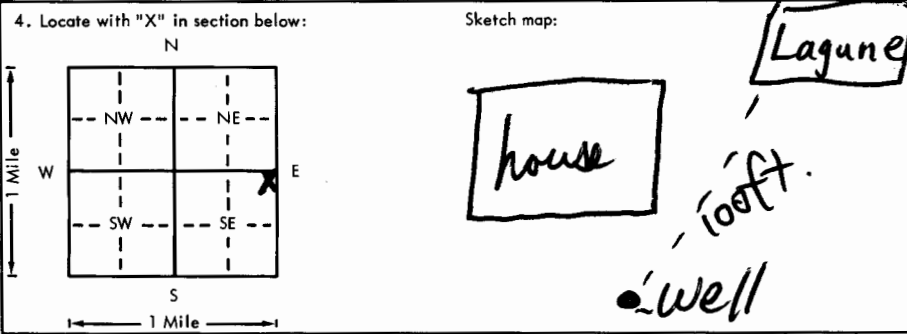


USE TYPEWRITER OR BALL
POINT PEN-PRESS FIRMLY,
PRINT CLEARLY.

WATER WELL RECORD
KSA 82a-1201-1215

Kansas Department of Health and
Environment-Division of Environment
(Water well Contractors)
Topeka, Kansas 66620

1. Location of well: County <u>HARVEY.</u> Fraction <u>NE 1/4 NE 1/4</u> Section number <u>24</u> Township number <u>24</u> S Range number <u>1</u> <u>EW</u>																			
2. Distance and direction from nearest town or city: <u>7 1/2 miles No. Valley Ctr. Ks.</u>																			
3. Owner of well: <u>Ken Ellard</u> R.R. or street: <u>Bedford</u> City, state, zip code: <u>KS 67135</u>																			
4. Locate with "X" in section below: 																			
5. Type and color of material																			
<table border="1"><thead><tr><th></th><th>From</th><th>To</th></tr></thead><tbody><tr><td><u>Top soil.</u></td><td><u>0</u></td><td><u>3</u></td></tr><tr><td><u>red clay.</u></td><td><u>3</u></td><td><u>38</u></td></tr><tr><td><u>limestone</u></td><td><u>38</u></td><td><u>40</u></td></tr><tr><td><u>fine sand</u></td><td><u>40</u></td><td><u>50</u></td></tr><tr><td><u>Charcoal shale</u></td><td><u>50</u></td><td><u>75</u></td></tr>
6. Bore hole dia. <u>1 1/2</u> in. Completion date <u>7/7/78</u> Well depth <u>75</u> ft.																			
7. <input checked="" type="checkbox"/> Cable tool <input checked="" type="checkbox"/> Rotary <input type="checkbox"/> Driven <input type="checkbox"/> Dog <input type="checkbox"/> Hollow rod <input type="checkbox"/> Jetted <input type="checkbox"/> Bored <input type="checkbox"/> Reverse rotary																			
8. Use: <input checked="" type="checkbox"/> Domestic <input type="checkbox"/> Public supply <input type="checkbox"/> Industry <input type="checkbox"/> Irrigation <input type="checkbox"/> Air conditioning <input type="checkbox"/> Stock <input type="checkbox"/> Lawn <input type="checkbox"/> Oil field water <input type="checkbox"/> Other																			
9. Casing: Material <u>Styrene</u> <input checked="" type="checkbox"/> Above or below Threaded <input type="checkbox"/> Welded <input checked="" type="checkbox"/> Surface <u>1 1/2</u> in. RMP <input checked="" type="checkbox"/> PVC <input type="checkbox"/> Weight <u>11.50</u> lbs./ft. Dia. <u>5</u> in. to <u>75</u> ft. depth Wall Thickness: inches or Dia. <u>5</u> in. to <u>75</u> ft. depth gage No. <u>1200</u>																			
10. Screen: Manufacturer's name <u>Sunflower</u> Type <u>200</u> Dia. <u>5</u> in. Slot/gauze <u>1/16</u> Length <u>15</u> ft. Set between <u>60</u> ft. and <u>75</u> ft. Gravel pack? <u>yes</u> Size range of material <u>3/8</u>																			
11. Static water level: <u>18</u> ft. below land surface Date <u>7-7-78</u> mo./day/yr.																			
12. Pumping level below land surfaces: <u>28</u> ft. after <u>1</u> hrs. pumping <u>15</u> g.p.m. <u>28</u> ft. after <u>1</u> hrs. pumping <u>15</u> g.p.m. Estimated maximum yield <u>20-35</u> g.p.m.																			
13. Water sample submitted: <u>Yes</u> <input checked="" type="checkbox"/> No <input type="checkbox"/> Date <u>7-7-78</u> mo./day/yr.																			
14. Well head completion: <input checked="" type="checkbox"/> Pitless adapter <u>12</u> inches above grade																			
15. Well grouted? <u>yes</u> With: <u>Neat cement</u> <input type="checkbox"/> Bentonite <input checked="" type="checkbox"/> Concrete <input type="checkbox"/> Depth: From <u>3</u> ft. to <u>13</u> ft.																			
16. Nearest source of possible contamination: <u>100</u> ft. Direction <u>NE</u> Type <u>Lagune</u> Well disinfected upon completion? <input checked="" type="checkbox"/> Yes <input type="checkbox"/> No																			
17. Pump: <input checked="" type="checkbox"/> Not installed Manufacturer's name <u>FW</u> Model number <u>10178</u> HP <u>1/2</u> Vol <u>220</u> Length of drop pipe <u>60</u> ft. capacity <u>10</u> g.p.m. Type: <input checked="" type="checkbox"/> Submersible <input type="checkbox"/> Turbine <input type="checkbox"/> Jet <input type="checkbox"/> Reciprocating <input type="checkbox"/> Centrifugal <input type="checkbox"/> Other																			
18. Elevation:																			
19. Remarks: <u>Customer to furnish 4x4x4" slab around casing at grade per State Regulations</u> <u>Signed X Ken W. Ellard</u>																			
20. Water well contractor's certification: This well was drilled under my jurisdiction and this report is true to the best of my knowledge and belief. <u>Wm. H. Church</u> <u>318</u> Business name <u>Church</u> License No. <u>24-10</u> Address <u>24 NE</u> Signed <u>7/7/78</u> Authorized representative																			