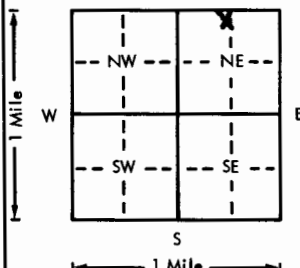


USE TYPEWRITER OR BALL  
POINT PEN—PRESS FIRMLY,  
PRINT CLEARLY.

WATER WELL RECORD  
KSA 82a-1201-1215

Kansas Department of Health and  
Environment—Division of Environment  
(Water well Contractors)  
Topeka, Kansas 66620

1. Location of well:		County <b>Harvey</b>	Fraction <b>NE 1/4 NW 1/4 NE 1/4</b>	Section number <b>28</b>	Township number <b>T 24 S</b>	Range number <b>R 1W E (W)</b>
2. Distance and direction from nearest town or city: Street address of well location if in city: <b>1 1/2 North of Sedgwick, Kansas 1/8 West of Ridge Road</b>				3. Owner of well: <b>Melvin Noland</b> R. R. #1 <b>Sedgwick, Kansas</b> City, state, zip code:		
4. Locate with "X" in section below: N W E S 1 Mile 1 Mile on the South Side of the road.				6. Bore hole dia. <b>11</b> in. Completion date <b>11-8-77</b> Well depth <b>65</b> ft.		
				7. <input checked="" type="checkbox"/> Cable tool <input type="checkbox"/> Rotary <input type="checkbox"/> Driven <input type="checkbox"/> Dug <input type="checkbox"/> Hollow rod <input type="checkbox"/> Jetted <input type="checkbox"/> Bored <input type="checkbox"/> Reverse rotary		
				8. Use: <input checked="" type="checkbox"/> Domestic <input type="checkbox"/> Public supply <input type="checkbox"/> Industry <input type="checkbox"/> Irrigation <input type="checkbox"/> Air conditioning <input type="checkbox"/> Stock <input type="checkbox"/> Lawn <input type="checkbox"/> Oil field water <input type="checkbox"/> Other		
5. Type and color of material				From	To	9. Casing: Material <b>styrne</b> Height: Above or below Threaded <input checked="" type="checkbox"/> Welded <input type="checkbox"/> Surface <b>12</b> in. RMP <b>5</b> <b>PVC</b> Weight <b>65</b> lbs./ft. Dia. <b>5</b> in. to <b>65</b> ft. depth Wall Thickness: inches or Dia. <b>5</b> in. to <b>65</b> ft. depth gage No. <b>200</b>
Topsoil				0	3	10. Screen: Manufacturer's name <b>Sunflower Plastic</b> Type <b>styrne</b> Dia. <b>5"</b> Slot/gauze <b>.06</b> Length <b>15'</b> Set between <b>50</b> ft. and <b>65</b> ft. Gravel pack? <b>yes</b> Size range of material <b>1/4-1/8"</b>
Clay				3	40	11. Static water level: <b>40</b> ft. below land surface Date <b>11-8-77</b>
Fine Sand				40	65	12. Pumping level below land surfaces: ____ ft. after ____ hrs. pumping ____ g.p.m. ____ ft. after ____ hrs. pumping ____ g.p.m. Estimated maximum yield ____ g.p.m.
						13. Water sample submitted: ____ mo./day/yr. Yes ____ No ____ Date ____
						14. Well head completion: <b>12</b> capped ____ Pitless adapter ____ inches above grade
						15. Well grouted? <b>yes</b> <b>1-2</b> fine sand mix With: <b>Neat cement</b> <b>14</b> Bentonite <input checked="" type="checkbox"/> Concrete Depth: From ____ ft. to ____ ft.
						16. Nearest source of possible contamination: <b>Septic</b> ft. <b>200</b> Direction <b>West</b> Type <b>Tank</b> Well disinfected upon completion? <input checked="" type="checkbox"/> Yes ____ No ____
						17. Pump: <input checked="" type="checkbox"/> Not installed Manufacturer's name ____ Model number ____ HP ____ Volts ____ Length of drop pipe ____ ft. capacity ____ g.p.m. Type: ____ Submersible ____ Turbine ____ Jet ____ Reciprocating ____ Centrifugal ____ Other
(Use a second sheet if needed)						20. Water well contractor's certification: This well was drilled under my jurisdiction and this report is true to the best of my knowledge and belief. <b>Harp Well &amp; Pump</b> <b>236</b> Business name License No. Address <b>Wichita, Kansas</b> Signed <b>M. Arnold</b> Date <b>12-10-77</b> Authorized representative
18. Elevation:		19. Remarks: <b>Flat Ground</b>				
Topography: ____ Hill ____ Slope ____ Upland ____ Valley						

24 - 10 28 NE NW NE  
T R Sec 1/4 1/4 1/4