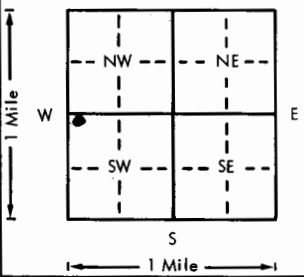


USE TYPEWRITER OR BALL  
POINT PEN-PRESS FIRMLY,  
PRINT CLEARLY.

WATER WELL RECORD  
KSA 82a-1201-1215

Kansas Department of Health and  
Environment-Division of Environment  
(Water well Contractors)  
Topeka, Kansas 66620

1. Location of well:	County <b>Harvey</b>	Fraction <b>NW 1/4 NW 1/4 SW 1/4</b>	Section number <b>29</b>	Township number <b>T 24 S</b>	Range number <b>R 1 W E/W</b>
2. Distance and direction from nearest town or city: Street address of well location if in city:	<b>1/2 W - 1 N 1/2 N. SEDGWICK.</b>		3. Owner of well: R.R. or street: <b>Wilbur Kurr</b> City, state, zip code: <b>Sedgwick, Kansas 67135</b>		
4. Locate with "X" in section below: N W E S 1 Mile Sketch map:			6. Bore hole dia. <b>26</b> in. Completion date <b>8/29/77</b> Well depth <b>150</b> ft.		
5. Type and color of material	From	To	7. <input type="checkbox"/> Cable tool <input type="checkbox"/> Rotary <input type="checkbox"/> Driven <input type="checkbox"/> Dug <input type="checkbox"/> Hollow rod <input type="checkbox"/> Jetted <input checked="" type="checkbox"/> Bored <input checked="" type="checkbox"/> Reverse rotary		
<b>Old Pit to clay</b>	<b>0</b>	<b>10</b>	8. Use: <input type="checkbox"/> Domestic <input type="checkbox"/> Public supply <input type="checkbox"/> Industry <input checked="" type="checkbox"/> Irrigation <input type="checkbox"/> Air conditioning <input type="checkbox"/> Stock <input type="checkbox"/> Lawn <input type="checkbox"/> Oil field water <input type="checkbox"/> Other		
<b>Clay</b>	<b>10</b>	<b>30</b>	9. Casing: Material <b>Transite</b> Above or below Threaded <input type="checkbox"/> Welded <input checked="" type="checkbox"/> Surface <b>12</b> in. RMP <input type="checkbox"/> PVC <input checked="" type="checkbox"/> Weight <b>30</b> lbs./ft. Dia. <b>16</b> in. to <b>98</b> ft. depth Wall Thickness: inches or Dia. <input type="checkbox"/> in. to <input type="checkbox"/> ft. depth gage No. <b>2263/4</b>		
<b>Med. sand</b>	<b>30</b>	<b>60</b>	10. Screen: Manufacturer's name <b>Johnson</b> Type <b>Sawed</b> Dia. <b>16</b> Slot/gauze <b>3/16</b> Length Set between <b>98</b> ft. and <b>150</b> ft. ft. and <input type="checkbox"/> ft. Gravel pack? <b>yes</b> Size range of material <b>1/8-4</b>		
<b>Med. sand to hard brown clay</b>	<b>60</b>	<b>70</b>	11. Static water level: <input type="checkbox"/> mo./day/yr. <b>28</b> ft. below land surface Date <b>8/29/77</b>		
<b>Clay mixed with med. sand</b>	<b>70</b>	<b>90</b>	12. Pumping level below land surfaces: <b>80</b> ft. after <b>1</b> hrs. pumping <b>900</b> g.p.m. <input type="checkbox"/> ft. after <input type="checkbox"/> hrs. pumping <input type="checkbox"/> g.p.m. Estimated maximum yield <b>900</b> g.p.m.		
<b>Med. sand</b>	<b>90</b>	<b>100</b>	13. Water sample submitted: <input type="checkbox"/> mo./day/yr. <input type="checkbox"/> Yes <input checked="" type="checkbox"/> No Date		
<b>Hard solid brownish red clay</b>	<b>100</b>	<b>120</b>	14. Well head completion: <input type="checkbox"/> Pitless adapter <b>10</b> inches above grade		
<b>Med. sand w/ 40 to 50% clay</b>	<b>120</b>	<b>150</b>	15. Well grouted? <b>yes</b> With: <input type="checkbox"/> Neat cement <input type="checkbox"/> Bentonite <input checked="" type="checkbox"/> Concrete Depth: From <b>0</b> ft. to <b>10</b> ft.		
			16. Nearest source of possible contamination: ft. <input type="checkbox"/> Direction <input type="checkbox"/> Type <input type="checkbox"/> Well disinfected upon completion? <input type="checkbox"/> Yes <input checked="" type="checkbox"/> No		
			17. Pump: <input type="checkbox"/> Not installed Manufacturer's name <b>Western Land Roller</b> Model number <b>2-12. D</b> HP <input type="checkbox"/> Volts <input type="checkbox"/> Length of drop pipe <b>90</b> ft. capacity <b>1000</b> g.p.m. Type: <input type="checkbox"/> Submersible <input type="checkbox"/> Turbine <input type="checkbox"/> Jet <input type="checkbox"/> Reciprocating <input type="checkbox"/> Centrifugal <input type="checkbox"/> Other		
(Use a second sheet if needed)					
18. Elevation:	19. Remarks:		20. Water well contractor's certification: This well was drilled under my jurisdiction and this report is true to the best of my knowledge and belief. <b>Darling Drilling Co. 189</b> Business name <b>121 W. 4th Hutchinson, Ks</b> License No. <b>5-5</b> Address <b>Donald J. Darling</b> Signed <b>Donald J. Darling</b> Authorized representative		
Topography: <input type="checkbox"/> Hill <input type="checkbox"/> Slope <input checked="" type="checkbox"/> Upland <input type="checkbox"/> Valley					