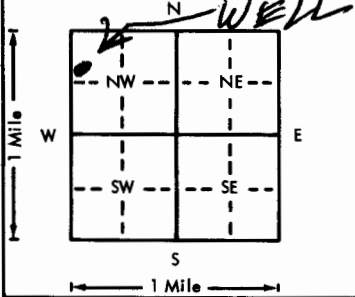


USE TYPEWRITER OR BALL  
POINT PEN-PRESS FIRMLY,  
PRINT CLEARLY.

WATER WELL RECORD  
KSA 82a-1201-1215

Kansas Department of Health and  
Environment-Division of Environment  
(Water well Contractors)  
Topeka, Kansas 66620

X Location of well: County <u>Harney</u> <del>SEDOGWICK</del>		Fraction <u>1/4 NW 1/4 NW 1/4</u>	Section number <u>29</u>	Township number <u>T 24</u>	Range number <u>S R 1</u>	<u>W</u>
X Distance and direction from nearest town or city: <u>2 West</u> Street address of well location if in city: <u>3RD SEDGWICK</u>			3. Owner of well: <u>SAM MCGINN</u> R.R. or street: <u>RR 1</u> City, state, zip code: <u>SEDOGWICK, KANSAS 67135</u>			
4. Locate with "X" in section below: 		Sketch map:		6. Bore hole dia. <u>30</u> in. Completion date <u>4-1-77</u> Well depth <u>120</u> ft.		
5. Type and color of material		From		To		7. <input type="checkbox"/> Cable tool <input type="checkbox"/> Rotary <input type="checkbox"/> Driven <input type="checkbox"/> Dug <input type="checkbox"/> Hollow rod <input type="checkbox"/> Jetted <input type="checkbox"/> Bored <input checked="" type="checkbox"/> Reverse rotary
		Top Soil		0 5		8. Use: <input type="checkbox"/> Domestic <input type="checkbox"/> Public supply <input type="checkbox"/> Industry <input checked="" type="checkbox"/> Irrigation <input type="checkbox"/> Air conditioning <input type="checkbox"/> Stock <input type="checkbox"/> Lawn <input type="checkbox"/> Oil field water <input type="checkbox"/> Other
		CLAY BR.		5 8		9. Casing: Material <u>PVC</u> Height: Above or below Threaded <input type="checkbox"/> Welded <input type="checkbox"/> Surface <u>24</u> in. RMP <input type="checkbox"/> PVC <input type="checkbox"/> Weight <input type="checkbox"/> lbs./ft.
		CLAY GREY		8 38		Dia. <u>1 1/2</u> in. to <u>120</u> ft. depth Wall Thickness: inches or Dia. <u>1</u> in. to <u>1</u> ft. depth gage No. <u>429</u>
		SAND - COARSE		38 92		10. Screen: Manufacturer's name <u>JET STREAM</u> Type <u>PVC</u> Dia. <u>1 1/2</u> Slot/gauze <u>0.85</u> Length <u>40</u> Set between <u>80</u> ft. and <u>120</u> ft. ft. and <u>120</u> ft. Gravel pack? <u>42</u> size range of material <u>1/4"</u>
		CLAY GREY		42 44		11. Static water level: <u>28</u> ft. below land surface Date <u>4-2-77</u>
		SAND - MED TO COARSE		44 71		12. Pumping level below land surfaces: ft. after <u>1</u> hrs. pumping <u>1</u> g.p.m. ft. after <u>1</u> hrs. pumping <u>1</u> g.p.m. Estimated maximum yield <u>1</u> g.p.m.
		CLAY - MIXED w/ SAND		71 78		13. Water sample submitted: <u>1</u> mo./day/yr. <input checked="" type="checkbox"/> Yes <input type="checkbox"/> No Date <u>4-28-77</u>
		SAND FINE TO MED		78 115		14. Well head completion: <input type="checkbox"/> Pitless adapter <u>18</u> inches above grade
		SAND - MIXED w/ CLAY		115 120		15. Well grouted? <u>yes</u> <u>Puddled Clay</u> With: <input type="checkbox"/> Neat cement <input type="checkbox"/> Bentonite <input type="checkbox"/> Concrete Depth: From <u>0</u> ft. to <u>10</u> ft.
HARD RED CLAY		120 125		16. Nearest source of possible contamination: <u>FEED</u> ft. <u>1200</u> Direction <u>SW</u> Type <u>LOT</u> Well disinfected upon completion? <input type="checkbox"/> Yes <input checked="" type="checkbox"/> No		
CASED 120 ft.				17. Pump: <u>Not installed</u> Manufacturer's name <u>WESTERN LAND</u> Model number <u>8M</u> HP <u>60</u> Length of drop pipe <u>90</u> ft. capacity <u>1200</u> g.p.m. Type: <input type="checkbox"/> Submersible <input checked="" type="checkbox"/> Turbine <input type="checkbox"/> Jet <input type="checkbox"/> Reciprocating <input type="checkbox"/> Centrifugal <input type="checkbox"/> Other		
18. Elevation:		19. Remarks:		20. Water well contractor's certification: This well was drilled under my jurisdiction and this report is true to the best of my knowledge and belief. <u>PETERSON IRR. INC.</u> <u>138A</u> Business name License No. Address <u>Box 150 LINCOLN, KS</u> Signed <u>Walter H. Peterson</u> Date <u>5</u> Authorized representative <u>20-77</u>		