


1 LOCATION OF WATER WELL:		Fraction	Section Number		Township Number	Range Number
County:	HARVEY 040	NE ¼ SE ¼ SE ¼	30		T 24 S	R 1 W E(W)

Distance and direction from nearest town or city street address of well if located within city?

1 West of Sedawick, KS., $\frac{1}{2}$ North of West Sd. of Rd.

2	WATER WELL OWNER:	Wilbur Kurr	
	RR#, St. Address, Box # :	Rt. #2	Board of Agriculture, Division of Water Resources
	City, State, ZIP Code :	Sedgwick, KS.	Application Number: 12533

3 LOCATE WELL'S LOCATION WITH AN "X" IN SECTION BOX: 4 DEPTH OF COMPLETED WELL 155 ft. ELEVATION: 27

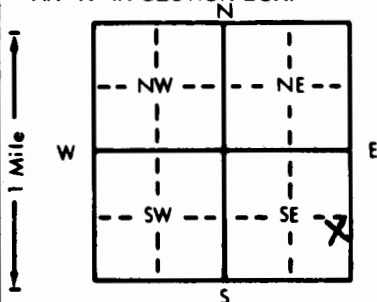

4 DEPTH OF COMPLETED WELL. 155 ft. ELEVATION: 27

Depth(s) Groundwater Encountered 1. 27 ft. 2. _____ ft. 3. _____ ft.
WELL'S STATIC WATER LEVEL 27 ft. below land surface measured on mo/day/yr 9-17-87

	Pump test data:	Well water was		ft. after		hours pumping		gpm
Est. Yield		gpm:	Well water was		ft. after		hours pumping	
								gpm

Bore Hole Diameter 30 in. to ft., and in. to ft.

WELL WATER TO BE USED AS:		5 Public water supply	8 Air conditioning	11 Injection well
1 Domestic	3 Feedlot	6 Oil field water supply	9 Dewatering	12 Other (Specify below)

2 Irrigation 4 Industrial 7 Lawn and garden only 10 Observation well
Was a chemical/bacteriological sample submitted to Department? Yes.....No.....**X**.....; If yes, mo/day/yr sample was sub

5	TYPE OF BLANK CASING USED:	5 Wrought iron	8 Concrete tile	CASING JOINTS: Glued Clamped . X . . .
---	----------------------------	----------------	-----------------	---

1 Steel	3 RMP (SR)	6 Asbestos-Cement	9 Other (specify below)	Welded
2 PVC	4 ABS	7 Fiberglass	Transite	Threaded

Blank casing diameter 16 in. to 51 ft., Dia in. to ft., Dia in. to ft.
Casing height above land surface 12 in., weight 37 lbs./ft. Wall thickness or gauge No. 3/4"

TYPE OF SCREEN OR PERFORATION MATERIAL:			7 PVC	<u>10 Asbestos-cement</u>	Transite
1 Steel	3 Stainless steel	5 Fiberglass	8 RMP (SR)	11 Other (specify)	

2 Brass	4 Galvanized steel	6 Concrete tile	9 ABS	12 None used (open hole)
SCREEN OR PERFORATION OPENINGS ARE:		5 Gauzed wrapped	8 Saw cut	11 None (open hole)

1 Continuous slot	3 Mill slot	6 Wire wrapped	9 Drilled holes
2 Louvered shutter	4 Key punched	7 Torch cut	10 Other (specify)

SCREEN-PERFORATED INTERVALS: From 51 ft. to 64 ft. From 77 ft. to 102 ft.
From 127 ft. to 155 ft. From ft. to ft.

GRAVEL PACK INTERVALS: From.....20.....ft. to.....155.....ft., From.....ft. to.....ft.
From.....ft. to.....ft., From.....ft. to.....ft.

6 GROUT MATERIAL: 1 Neat cement 2 Cement grout 3 Bentonite 4 Other
Grout Intervals: From 0 ft to 10 ft From 10 ft to 20 ft From ft to ft

What is the nearest source of possible contamination:			10 Livestock pens	14 Abandoned water well
1 Septic tank	4 Lateral lines	7 Pit privy	11 Fuel storage	15 Oil well/Gas well


Direction from well?		LITHOLOGIC LOG		FROM		TO		LITHOLOGIC LOG	
----------------------	--	----------------	--	------	--	----	--	----------------	--

[illegible]

7 CONTRACTOR'S OR LANDOWNER'S CERTIFICATION: This water well was (1) constructed, (2) reconstructed, or (3) plugged under my jurisdiction and was completed on (mo/day/year) 9-17-87 and this record is true to the best of my knowledge and belief. Kansas

Water Well Contractor's License No. 236 This Water Well Record was completed on (mo/day/yr) 3-31-88
under the business name of Harp Well & Pump Service, Inc. by (signature) Mary Arnold

INSTRUCTIONS: Use typewriter or ball point pen. **PLEASE PRESS FIRMLY** and **PRINT** clearly. Please fill in blanks, underline or circle the correct answers. Send top three copies to Kansas Department of Health and Environment, Bureau of Water Protection, Topeka, Kansas 66620-7320, Telephone: 913-862-9360. Send one to **WATER WELL OWNER** and retain one for your records.