


1 LOCATION OF WATER WELL:	Fraction	Section Number	Township Number	Range Number
County: <u>Harvey</u>	<u>NW 1/4 NE 1/4 SE 1/4</u>	<u>30</u>	<u>T 24 S</u>	<u>R 1 W E/W</u>

Distance and direction from nearest town or city street address of well if located within city?

3 1/2 miles NW Sedgwick

2 WATER WELL OWNER:	Board of Agriculture, Division of Water Resources
RR#, St. Address, Box #	Application Number:
City, State, ZIP Code	

3 LOCATE WELL'S LOCATION WITH AN "X" IN SECTION BOX:	4 DEPTH OF COMPLETED WELL..... ft. ELEVATION:..... ft.
--	--

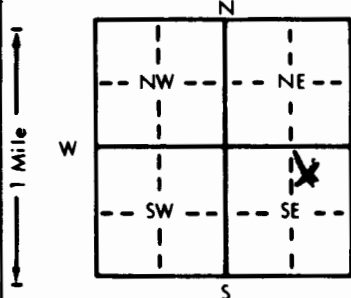

Depth(s) Groundwater Encountered 1..... ft. 2..... ft. 3..... ft.

WELL'S STATIC WATER LEVEL..... ft. below land surface measured on mo/day/yr

Pump test data: Well water was..... ft. after..... hours pumping..... gpm

Est. Yield..... gpm: Well water was..... ft. after..... hours pumping..... gpm

Bore Hole Diameter..... in. to..... ft., and..... in. to..... ft.

WELL WATER TO BE USED AS: 5 Public water supply 8 Air conditioning 11 Injection well

1 Domestic 3 Feedlot 6 Oil field water supply 9 Dewatering 12 Other (Specify below)

2 Irrigation 4 Industrial 7 Lawn and garden only 10 Monitoring well

Was a chemical/bacteriological sample submitted to Department? Yes..... No..... If yes, mo/day/yr sample was sub-

mitted Water Well Disinfected? Yes..... No

5 TYPE OF BLANK CASING USED:	5 Wrought iron	8 Concrete tile	CASING JOINTS: Glued..... Clamped.....
------------------------------	----------------	-----------------	--

1 Steel 3 RMP (SR) 6 Asbestos-Cement 9 Other (specify below) Welded.....

2 PVC 4 ABS 7 Fiberglass Threaded.....

Blank casing diameter 6" in. to..... ft., Dia..... in. to..... ft., Dia..... in. to..... ft.Casing height above land surface 3 ft below in., weight..... lbs./ft. Wall thickness or gauge No.....

TYPE OF SCREEN OR PERFORATION MATERIAL: 7 PVC 10 Asbestos-cement

1 Steel 3 Stainless steel 5 Fiberglass 8 RMP (SR) 11 Other (specify).....

2 Brass 4 Galvanized steel 6 Concrete tile 9 ABS 12 None used (open hole)

SCREEN OR PERFORATION OPENINGS ARE: 5 Gauzed wrapped 8 Saw cut 11 None (open hole)

1 Continuous slot 3 Mill slot 6 Wire wrapped 9 Drilled holes

2 Louvered shutter 4 Key punched 7 Torch cut 10 Other (specify).....

SCREEN-PERFORATED INTERVALS: From..... ft. to..... ft., From..... ft. to..... ft.

From..... ft. to..... ft., From..... ft. to..... ft.

GRAVEL PACK INTERVALS: From..... ft. to..... ft., From..... ft. to..... ft.

From..... ft. to..... ft., From..... ft. to..... ft.

6 GROUT MATERIAL:	1 Neat cement	2 Cement grout	3 Bentonite	4 Other
-------------------	---------------	----------------	-------------	---------

Grout Intervals: From 6 ft. to 3 ft., From..... ft. to..... ft., From..... ft. to..... ft.

What is the nearest source of possible contamination: 10 Livestock pens 14 Abandoned water well

1 Septic tank 4 Lateral lines 7 Pit privy 11 Fuel storage 15 Oil well/Gas well

2 Sewer lines 5 Cess pool 8 Sewage lagoon 12 Fertilizer storage 16 Other (specify below)

3 Watertight sewer lines 6 Seepage pit 9 Feedyard 13 Insecticide storage

Direction from well? 30 ft. Well is uphill from pens How many feet?

FROM	TO	LITHOLOGIC LOG	FROM	TO	PLUGGING INTERVALS
------	----	----------------	------	----	--------------------

7	12	road sand			
---	----	-----------	--	--	--

12	6	clay soil			
----	---	-----------	--	--	--

6	3	concrete			
---	---	----------	--	--	--

3	0	dirt			
---	---	------	--	--	--

OFFICE USE ONLY

T

R

EW

SEC.

1/4

1/4

1/4