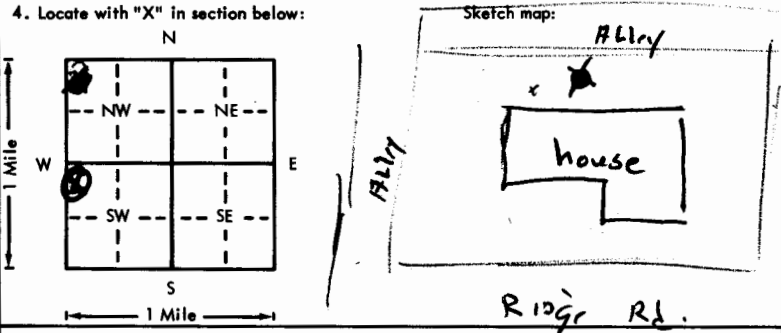


USE TYPEWRITER OR BALL
POINT PEN-PRESS FIRMLY,
PRINT CLEARLY.

WATER WELL RECORD
KSA 82a-1201-1215

Kansas Department of Health and
Environment-Division of Environment
(Water well Contractors)
Topeka, Kansas 66620

772-5403

1. Location of well:		County HARVEY	Fraction NW 1/4 NW 1/4 SW 1/4	Section number 34	Township number T 24	Range number S R 1 E
2. Distance and direction from nearest town or city: Street address of well location if in city:				3. Owner of well: LARRY SHERROD R.R. or street: 311 WASHINGTON City, state, zip code: SEDAWICK, KANS		
4. Locate with "X" in section below: 				6. Bore hole dia. 11 in. Completion date 4/8/77 Well depth 60 ft.		
5. Type and color of material				7. <input checked="" type="checkbox"/> Cable tool <input checked="" type="checkbox"/> Rotary <input type="checkbox"/> Driven <input type="checkbox"/> Dug <input type="checkbox"/> Hollow rod <input type="checkbox"/> Jetted <input type="checkbox"/> Bored <input type="checkbox"/> Reverse rotary		
				8. Use: <input type="checkbox"/> Domestic <input type="checkbox"/> Public supply <input type="checkbox"/> Industry <input type="checkbox"/> Irrigation <input type="checkbox"/> Air conditioning <input type="checkbox"/> Stock <input checked="" type="checkbox"/> Lawn <input type="checkbox"/> Oil field water <input type="checkbox"/> Other		
				9. Casing: Material plastic Height: above or below Threaded <input type="checkbox"/> Welded <input checked="" type="checkbox"/> Surface 12 in. RMP <input type="checkbox"/> PVC <input checked="" type="checkbox"/> Weight 2.25 lbs./ft. Dia. 5 in. to 60 ft. depth Wall Thickness: inches or Dia. <input type="checkbox"/> in. to <input type="checkbox"/> ft. depth Gauge No. 2.25		
				10. Screen: Manufacturer's name Robin-Tech - own slot Type PVC Dia. 5" Slot/gauze 1064 Length 30' Set between 30 ft. and 50 ft. Gravel pack? <input checked="" type="checkbox"/> Size range of material 1/8" / 1/4"		
				11. Static water level: 20 ft. below land surface Date 9/29/76 mo./day/yr.		
(Use a second sheet if needed)				12. Pumping level below land surfaces: 23 ft. after 1 hrs. pumping 20 g.p.m. ft. after <input type="checkbox"/> hrs. pumping <input type="checkbox"/> g.p.m. Estimated maximum yield 100/150 g.p.m.		
				13. Water sample submitted: <input type="checkbox"/> Yes <input checked="" type="checkbox"/> No Date <input type="checkbox"/>		
				14. Well head completion: <input type="checkbox"/> Pitless adapter 12 inches above grade		
				15. Well grouted? <input checked="" type="checkbox"/> With: <input checked="" type="checkbox"/> Neat cement <input type="checkbox"/> Bentonite <input type="checkbox"/> Concrete Depth: From 10 ft. to 0 ft.		
				16. Nearest source of possible contamination: ft. 60' Direction N Type Sewer Well disinfected upon completion? <input type="checkbox"/> Yes <input checked="" type="checkbox"/> No		
18. Elevation: Topography: <input type="checkbox"/> Hill <input type="checkbox"/> Slope <input type="checkbox"/> Upland <input type="checkbox"/> Valley				17. Pump: Manufacturer's name Dempster Model number 24-50-SR 1/2 Volts 220 Length of drop pipe 50 ft. capacity 18 g.p.m. Type: <input checked="" type="checkbox"/> Submersible <input type="checkbox"/> Turbine <input type="checkbox"/> Jet <input type="checkbox"/> Reciprocating <input type="checkbox"/> Centrifugal <input type="checkbox"/> Other		
				20. Water well contractor's certification: This well was drilled under my jurisdiction and this report is true to the best of my knowledge and belief. PAUL'S INC # 175 Business name License No. Address HOUSTON KANS Signed Paul Buehler Date 9/29/76 Authorized representative		
				19. Remarks:		
				24 - 10 34 NW 1/4 SW 1/4		
				24		