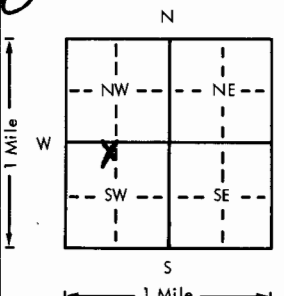
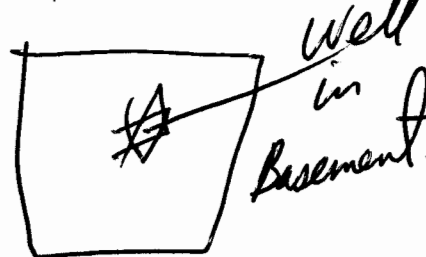


USE TYPEWRITER OR BALL
POINT PEN-PRESS FIRMLY,
PRINT CLEARLY.

WATER WELL RECORD
KSA 82a-1201-1215

Kansas Department of Health and
Environment-Division of Environment
(Water well Contractors)
Topeka, Kansas 66620

1. Location of well:		County: <u>HARVEY</u>	Section number: <u>35</u>	Township number: <u>24</u>	Range number: <u>1</u>
2. Distance and direction from nearest town or city:		3. Owner of well: <u>Bill Williamson</u>			
Street address of well location if in city:		R.R. or street: <u>R #1</u>			
		City, state, zip code: <u>Sedgwick, KS 67135</u>			
4. Locate with "X" in section below:		Sketch map:		6. Bore hole dia. <u>11</u> in. Completion date <u>1/31/77</u>	
				Well depth <u>65</u> ft.	
5. Type and color of material		From	To	7. <input checked="" type="checkbox"/> Cable tool <input checked="" type="checkbox"/> Rotary <input type="checkbox"/> Driven <input type="checkbox"/> Dug	
<u>Top soil.</u>		<u>0</u>	<u>8</u>	<input type="checkbox"/> Hollow rod <input type="checkbox"/> Jetted <input type="checkbox"/> Bored <input type="checkbox"/> Reverse rotary	
<u>clay.</u>		<u>8</u>	<u>18</u>	8. Use: <input checked="" type="checkbox"/> Domestic <input type="checkbox"/> Public supply <input type="checkbox"/> Industry	
<u>fine sand.</u>		<u>18</u>	<u>28</u>	<input type="checkbox"/> Irrigation <input type="checkbox"/> Air conditioning <input type="checkbox"/> Stock	
<u>dark blue clay & black shale.</u>		<u>28</u>	<u>65</u>	<input type="checkbox"/> Lawn <input type="checkbox"/> Oil field water <input type="checkbox"/> Other	
				9. Casing: Material <u>PVC</u> Height: <u>0</u> Above or below	
				Threaded <input type="checkbox"/> Welded <input checked="" type="checkbox"/> Surface <u>12</u> in.	
				RMP <input type="checkbox"/> PVC <input checked="" type="checkbox"/> Weight <u>2.31</u> lbs./ft.	
				Dia. <u>5</u> in. to <u>65</u> ft. depth Wall Thickness: inches or	
				Dia. <u>5</u> in. to <u>65</u> ft. depth gage No. <u>214</u>	
				10. Screen: Manufacturer's name <u>MPI</u>	
				Type <u>PVC</u> Dia. <u>5</u> in.	
				Slot/gauze <u>1/16</u> Length <u>10</u> ft.	
				Set between <u>55</u> ft. and <u>65</u> ft.	
				Gravel pack? <u>yes</u> Size range of material <u>3/8</u>	
				11. Static water level: <u>40</u> ft. below land surface Date <u>1/31/77</u>	
				12. Pumping level below land surfaces:	
				<u>48</u> ft. after <u>1/2</u> hrs. pumping <u>20</u> g.p.m.	
				<u>35</u> ft. after <u>1/2</u> hrs. pumping <u>35</u> g.p.m.	
				Estimated maximum yield <u>35</u> g.p.m.	
				13. Water sample submitted: <u>Yes</u> <input checked="" type="checkbox"/> No <input type="checkbox"/> Date <u>1/31/77</u>	
				14. Well head completion:	
				<u>Pitless adapter</u> <u>12</u> inches above grade	
				15. Well grouted? <u>yes</u>	
				With: <input checked="" type="checkbox"/> Neat cement <input type="checkbox"/> Bentonite <input type="checkbox"/> Concrete	
				Depth: From <u>7</u> ft. to <u>17</u> ft.	
				16. Nearest source of possible contamination:	
				ft. <u>None</u> Direction <u>None</u>	
				Well disinfected upon completion? <input checked="" type="checkbox"/> Yes <input type="checkbox"/> No	
				17. Pump: <u>6/10/77</u> Not installed	
				Manufacturer's name <u>Valley</u>	
				Model number <u>1806</u> HP <u>1/2</u> Volt <u>220</u>	
				Length of drop pipe <u>56</u> ft. capacity <u>20</u> g.p.m.	
				Type:	
				<input checked="" type="checkbox"/> Submersible <input type="checkbox"/> Turbine	
				<input type="checkbox"/> Jet <input type="checkbox"/> Reciprocating	
				<input type="checkbox"/> Centrifugal <input type="checkbox"/> Other	
18. Elevation:		19. Remarks:		20. Water well contractor's certification:	
Topography:				This well was drilled under my jurisdiction and this report is true to the best of my knowledge and belief.	
<input checked="" type="checkbox"/> Hill				<u>Weninger Bully</u> <u>318</u>	
<input type="checkbox"/> Slope				Business name <u>Cotwich</u> License No. <u>7/7/77</u>	
<input type="checkbox"/> Upland				Address <u>Cotwich</u>	
<input type="checkbox"/> Valley				Signed <u>Weninger</u> Date <u>7/7/77</u>	