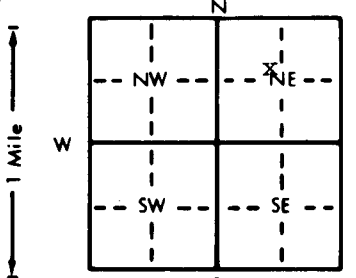


1 LOCATION OF WATER WELL:	Fraction	Section Number	Township Number	Range Number
County: Harvey	NE ¼ SW ¼ NE ¼	16	T 24 S	R 1 E/W

Distance and direction from nearest town or city street address of well if located within city?

Approximately 3½ miles north of Sedgwick

2 WATER WELL OWNER:	Public Wholesale Water Supply District #17	
RR#, St. Address, Box # :	P.O. Box 426	Board of Agriculture, Division of Water Resources
City, State, ZIP Code :	Newton, KS 67114	Application Number: 41,419

3 LOCATE WELL'S LOCATION WITH AN "X" IN SECTION BOX:	4 DEPTH OF COMPLETED WELL: 122 ft. ELEVATION: unknown
	Depth(s) Groundwater Encountered 1. ft. 2. ft. 3. ft. WELL'S STATIC WATER LEVEL 16 ft. below land surface measured on mo/day/yr 9-8-99 Pump test data: Well water was not ch'd. ft. after hours pumping gpm Est. Yield unknown gpm: Well water was ft. after hours pumping gpm Bore Hole Diameter 42 in. to 123 ft., and in. to ft. WELL WATER TO BE USED AS: 5 Public water supply 8 Air conditioning 11 Injection well 1 Domestic 3 Feedlot 6 Oil field water supply 9 Dewatering 12 Other (Specify below) 2 Irrigation 4 Industrial 7 Lawn and garden only 10 Monitoring well Was a chemical/bacteriological sample submitted to Department? Yes No X If yes, mo/day/yr sample was submitted Water Well Disinfected? Yes X No

5 TYPE OF BLANK CASING USED:	5 Wrought iron	8 Concrete tile	CASING JOINTS: Glued Clamped	
1 Steel	3 RMP (SR)	6 Asbestos-Cement	9 Other (specify below)	Welded
2 PVC	4 ABS	7 Fiberglass		Threaded
Blank casing diameter 12 3/4 in. to 77 ft. Dia 12 3/4 in. to 122 ft. Dia in. to ft.				
Casing height above land surface 0 in. weight 49.56 lbs./ft. Wall thickness or gauge No. 375				
TYPE OF SCREEN OR PERFORATION MATERIAL:	5 Fiberglass	8 RMP (SR)	11 Other (specify)	
1 Steel	3 Stainless steel	9 ABS	12 None used (open hole)	
2 Brass	4 Galvanized steel	6 Concrete tile		
SCREEN OR PERFORATION OPENINGS ARE:	5 Gauzed wrapped	8 Saw cut	11 None (open hole)	
1 Continuous slot	3 Mill slot	6 Wire wrapped	9 Drilled holes	
2 Louvered shutter	4 Key punched	7 Torch cut	10 Other (specify)	
SCREEN-PERFORATED INTERVALS: From 77 ft. to 119 ft. From ft. to ft.				
GRAVEL PACK INTERVALS: From 60 ft. to 123 ft. From ft. to ft.				

6 GROUT MATERIAL:	1 Neat cement	2 Cement grout	3 Bentonite	4 Other 50% bentonite holeplug & 50% sand
Grout Intervals: From 0 ft. to 5 ft. From 26 ft. to 43 ft. From 50 ft. to 60 ft. From 60 ft. to 43 ft.				
What is the nearest source of possible contamination:	10 Livestock pens	14 Abandoned water well		
1 Septic tank	4 Lateral lines	7 Pit privy	11 Fuel storage	15 Oil well/Gas well
2 Sewer lines	5 Cess pool	8 Sewage lagoon	12 Fertilizer storage	16 Other (specify below)
3 Watertight sewer lines	6 Seepage pit	9 Feedyard	13 Insecticide storage	None known
Direction from well?	How many feet?			

FROM	TO	LITHOLOGIC LOG	FROM	TO	PLUGGING INTERVALS
0	2	Topsoil	105	107	Clay
2	8	Clay, gray to black	107	109	Sand and gravel, fine, medium
8	17	Clay, gray	109	119	Sand and gravel, fine, clay
17	28	Clay, gray, sticky			streak 109'
28	44	Sand, fine	119	123	Clay
44	54	Clay, brown			
54	60	Clay and sand			
60	68	Sand and gravel, fine, medium			
68	80	Clay, brown, sticky			
80	83	Sand and gravel with clay			
83	87	Sand, fine			
87	96	Sand and gravel, fine, medium			
96	97	Clay			
97	99	Sand and gravel with clay			
99	105	Sand and gravel, fine, medium			

7 CONTRACTOR'S OR LANDOWNER'S CERTIFICATION: This water well was (1) constructed, (2) reconstructed, or (3) plugged under my jurisdiction and was completed on (mo/day/year) 9-8-99 and this record is true to the best of my knowledge and belief. Kansas Water Well Contractor's License No. 185. This Water Well Record was completed on (mo/day/yr) 9-14-99 under the business name of Clarke Well & Equipment, Inc. by (signature) <i>Clarke Well &amp; Equipment, Inc.</i>
--