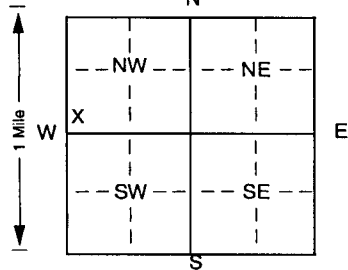


1 LOCATION OF WATER WELL:		Fraction		Section Number		Township Number		Range Number	
County: Harvey		SW 1/4 SW 1/4 NW 1/4		6		T 24 S		R 1 E (W)	

Distance and direction from nearest town or city street address of well if located within city?

Approximately 1 mile east of Halstead

2 WATER WELL OWNER: Public Wholesale Water Supply District No. 17		Board of Agriculture, Division of Water Resources Application Number: 19,268
RR#, St. Address, Box # : P.O. Box 426		
City, State, ZIP Code : Newton, KS 67114		

3 LOCATE WELL'S LOCATION WITH AN "X" IN SECTION BOX:		4 DEPTH OF COMPLETED WELL 143.77 ft. ELEVATION: unknown	
		Depth(s) Groundwater Encountered 1 ft. 2 ft. 3 ft. ft.	
		WELL'S STATIC WATER LEVEL 30 ft. below land surface measured on mo/day/yr 9-7-01	
		Pump test data: Well water was not checked ft. after hours pumping gpm	
		Est. Yield unknown gpm: Well water was ft. after hours pumping gpm	
		Bore Hole Diameter 40 in. to 144 ft., and in. to ft.	
WELL WATER TO BE USED AS: (5) Public water supply 8 Air conditioning 11 Injection well			
1 Domestic 3 Feedlot 6 Oil field water supply 9 Dewatering 12 Other (specify below)			
2 Irrigation 4 Industrial 7 Domestic (lawn & garden) 10 Monitoring well			
Was a chemical/bacteriological sample submitted to Department? Yes No (checked) If yes, mo/day/yr sample was submitted		Water Well Disinfected? Yes (checked) No	

5 TYPE OF BLANK CASING USED:		5 Wrought iron 8 Concrete tile CASING JOINTS: Glued Clamped (checked)	
(1) Steel 3 RMP (SR)		6 Asbestos-Cement 9 Other (specify below) Welded (checked)	
2 PVC 4 ABS		7 Fiberglass Threaded	
Blank casing diameter 12 in. to 87.11 ft., Dia 12 in. to 141 ft., Dia in. to ft.			
Casing height above land surface 33 in., weight 49.56 lbs./ft. Wall thickness or gauge No 375			
TYPE OF SCREEN OR PERFORATION MATERIAL:		7 PVC 10 Asbestos-cement	
1 Steel (3) Stainless steel 5 Fiberglass 8 RMP (SR) 11 Other (specify)			
2 Brass 4 Galvanized steel 6 Concrete tile 9 ABS 12 None used (open hole)			
SCREEN OR PERFORATION OPENINGS ARE:		5 Gauzed wrapped 8 Saw cut 11 None (open hole)	
(1) Continuous slot 3 Mill slot 6 Wire wrapped 9 Drilled holes			
2 Louvered shutter 4 Key punched 7 Torch cut 10 Other (specify) ft.			
SCREEN-PERFORATED INTERVALS: From 87.11 ft. to 137.95 ft., From ft. to ft.			
GRAVEL PACK INTERVALS: From 58 ft. to 144 ft., From ft. to ft.			
From ft. to ft., From ft. to ft.			

6 GROUT MATERIAL: 1 Neat cement (2) Cement grout 3 Bentonite 4 Other 50% Sand and 50% Bentonite Holeplug			
Compacted Soil			
Grout Intervals: From 0 ft. to 5 ft., From 5 ft. to 25 ft., From 25 ft. to 58 ft.			
What is the nearest source of possible contamination:		10 Livestock pens 14 Abandoned water well	
1 Septic tank 4 Lateral lines 7 Pit privy 11 Fuel storage 15 Oil well/Gas well			
2 Sewer lines 5 Cess pool 8 Sewage lagoon 12 Fertilizer storage 16 Other (specify below)			
3 Watertight sewer lines 6 Seepage pit 9 Feedyard 13 Insecticide storage None known			
Direction from well? How many feet?			

FROM	TO	LITHOLOGIC LOG	FROM	TO	PLUGGING INTERVALS
0	4	Topsoil			
4	8	Soil, silty			
8	16	Sand, fine			
16	31	Clay, red, brown, sticky			
31	33	Sand, fine			
33	55	Clay, some sand streaks, sticky			
55	112	Sand and gravel, fine, medium, coarse			
112	115	Sand and lots of Clay			
115	138	Sand and gravel, fine, medium, coarse			
138	144	Shale			

7 CONTRACTOR'S OR LANDOWNER'S CERTIFICATION: This water well was (1) constructed (2) reconstructed or (3) plugged under my jurisdiction and was completed on (mo/day/year) 9-7-01 and this record is true to the best of my knowledge and belief. Kansas Water Well Contractor's License No 185 This Water Well Record was completed on (mo/day/yr) 9-20-01 under the business name of Clarke Well & Equipment, Inc. by (signature)	
---	--

INSTRUCTIONS: Use typewriter or ball point pen. PLEASE PRESS FIRMLY and PRINT clearly. Please fill in blanks, underline or circle the correct answers. Send top three copies to Kansas Department of Health and Environment, Bureau of Water, Topeka, Kansas 66620-0001. Telephone 785-296-5524. Send one to WATER WELL OWNER and retain one for your records. Fee of \$5.00 for each constructed well.