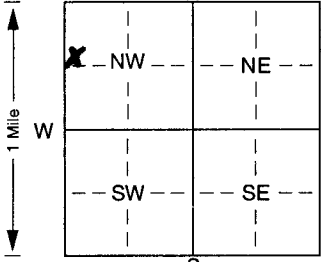


Harvey

1 LOCATION OF WATER WELL:	Fraction	Section Number	Township Number	Range Number
County: <u>Sedgwick</u>	<u>SW 1/4 NW 1/4 NW 1/4</u>	<u>29</u>	T <u>24</u> S	R <u>1</u> EW

Distance and direction from nearest town or city street address of well if located within city?  
From Sedgwick, KS: 2 miles West and 2 miles North

2 WATER WELL OWNER: <u>Loyd Farms</u>	Board of Agriculture, Division of Water Resources
RR#, St. Address, Box #: <u>503 Jefferson</u>	Application Number: <u>29114</u>
City, State, ZIP Code: <u>Sedgwick, KS 67135</u>	

3 LOCATE WELL'S LOCATION WITH AN "X" IN SECTION BOX:	4 DEPTH OF COMPLETED WELL: <u>120</u> ft. ELEVATION:
	Depth(s) Groundwater Encountered: <u>29</u> ft. 2. <u>29</u> ft. 3. <u>29</u> ft. WELL'S STATIC WATER LEVEL: <u>29</u> ft. below land surface measured on mo/day/yr <u>7-13-02</u> Pump test data: Well water was <u>70</u> ft. after <u>100</u> hours pumping <u>1050</u> gpm Est. Yield <u>1200</u> gpm: Well water was <u>75</u> ft. after <u>2</u> hours pumping <u>1200</u> gpm Bore Hole Diameter: <u>30</u> in. to <u>120</u> ft., and <u>2</u> in. to <u>120</u> ft. WELL WATER TO BE USED AS: 5 Public water supply 8 Air conditioning 11 Injection well 1 Domestic 3 Feedlot 6 Oil field water supply 9 Dewatering 12 Other (Specify below) <u>Irrigation</u> 4 Industrial 7 Domestic (lawn & garden) 10 Monitoring well Was a chemical/bacteriological sample submitted to Department? Yes. <u>N</u> No. <u>N</u> ; If yes, mo/day/yr sample was submitted Water Well Disinfected? Yes <u>X</u> No

5 TYPE OF BLANK CASING USED:	5 Wrought iron	8 Concrete tile	CASING JOINTS: Glued. <u>X</u> Clamped. <u>X</u>
1 Steel	3 RMP (SR)	6 Asbestos-Cement	9 Other (specify below)
<u>2 PVC</u>	4 ABS	7 Fiberglass	Welded
Blank casing diameter: <u>16</u> in. to <u>80</u> ft., Dia			Threaded
Casing height above land surface: <u>12</u> in., weight <u>16</u> lbs./ft. Wall thickness or gauge No. <u>1/2"</u>			
TYPE OF SCREEN OR PERFORATION MATERIAL:	<u>2 PVC</u>	10 Asbestos-cement	
1 Steel	3 Stainless steel	5 Fiberglass	8 RMP (SR)
2 Brass	4 Galvanized steel	6 Concrete tile	9 ABS
SCREEN OR PERFORATION OPENINGS ARE:	5 Gauzed wrapped	8 Saw cut	11 None (open hole)
1 Continuous slot	6 Wire wrapped	9 Drilled holes	
2 Louvered shutter	7 Torch cut	10 Other (specify)	

What is the nearest source of possible contamination:	1 Septic tank	4 Lateral lines	7 Pit privy	10 Livestock pens
	2 Sewer lines	5 Cess pool	8 Sewage lagoon	11 Fuel storage
	3 Watertight sewer lines	6 Seepage pit	9 Feedyard	12 Fertilizer storage
Direction from well?				13 Insecticide storage
				14 Abandoned water well
				15 Oil well/Gas well
				16 Other (specify below)
				<u>None Open Field</u>
				How many feet?

FROM	TO	LITHOLOGIC LOG	FROM	TO	PLUGGING INTERVALS
0	4	Topsoil			
4	28	Clay			
28	34	Sand			
34	38	Clay			
38	70	Small Gravel			
70	80	Clay			
80	100	Small Gravel			
100	102	Clay			
102	120	Small Gravel			
120		Clay Red			

7 CONTRACTOR'S OR LANDOWNER'S CERTIFICATION: This water well was <u>(1)</u> constructed, (2) reconstructed, or (3) plugged under my jurisdiction and was completed on (mo/day/year) <u>7-12-02</u> and this record is true to the best of my knowledge and belief. Kansas Water Well Contractor's Licence No. <u>238</u> This Water Well Record was completed on (mo/day/yr) <u>7-23-02</u> under the business name of <u>Wendy's Irrigation</u> by (signature) <u>Wendy's Irrigation</u>
---