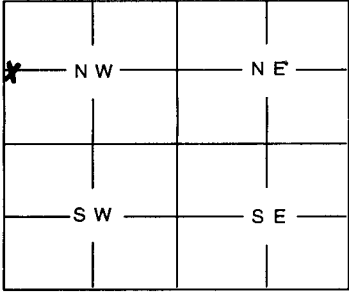


1	LOCATION OF WATER WELL: County: <u>Harvey</u>	Fraction <u>L 1/4 Wedge 1/4</u>	Section <u>NW 1/4</u>	Number <u>29</u>	Township <u>24</u>	Range <u>1 W</u>																								
Distance and direction from nearest town or city street address of well if located within city? <u>From Sedgwick, KS: 2 miles west and 2 miles North</u>																														
2	WATER WELL OWNER: <u>Lord Farms</u> RR #, St. Address, Box #: <u>503 Jefferson</u> City, State, ZIP Code: <u>Sedgwick, KS 67135</u> Board of Agriculture, Division of Water Resources Application Number: <u>29114</u>																													
3	MARK WELL'S LOCATION WITH AN "X" IN SECTION BOX: <div style="text-align: center; margin-top: 10px;">  </div>		4 DEPTH OF WELL <u>112</u> ft WELL'S STATIC WATER LEVEL <u>26</u> ft WELL WAS USED AS: <table style="width:100%; border: none;"> <tr> <td>1 Domestic</td> <td>5 Public Water Supply</td> <td>9 Dewatering</td> </tr> <tr> <td><input checked="" type="checkbox"/> Irrigation</td> <td>6 Oil Field Water Supply</td> <td>10 Monitoring Well</td> </tr> <tr> <td>3 Feedlot</td> <td>7 Domestic (Lawn & Garden)</td> <td>11 Injection Well</td> </tr> <tr> <td>4 Industrial</td> <td>8 Air Conditioning</td> <td>12 Other</td> </tr> </table> Was a chemical / bacteriological sample submitted to Department? Yes No <input checked="" type="checkbox"/> If yes, mo/day/yr sample was submitted Water Well Disinfected: Yes <input checked="" type="checkbox"/> No					1 Domestic	5 Public Water Supply	9 Dewatering	<input checked="" type="checkbox"/> Irrigation	6 Oil Field Water Supply	10 Monitoring Well	3 Feedlot	7 Domestic (Lawn & Garden)	11 Injection Well	4 Industrial	8 Air Conditioning	12 Other											
1 Domestic	5 Public Water Supply	9 Dewatering																												
<input checked="" type="checkbox"/> Irrigation	6 Oil Field Water Supply	10 Monitoring Well																												
3 Feedlot	7 Domestic (Lawn & Garden)	11 Injection Well																												
4 Industrial	8 Air Conditioning	12 Other																												
5	TYPE OF BLANK CASING USED: <table style="width:100%; border: none;"> <tr> <td>1 Steel</td> <td>3 RMP (SR)</td> <td>5 Wrought</td> <td>7 Fiberglass</td> <td>9 Other (Specify below)</td> </tr> <tr> <td><input checked="" type="checkbox"/> PVC</td> <td>4 ABS</td> <td>6 Asbestos-Cement</td> <td>8 Concrete Tile</td> <td>.....</td> </tr> </table> Blank casing diameter <u>16</u> in. Was casing pulled? Yes No <input checked="" type="checkbox"/> If yes, how much Casing height above or below and surface <u>36</u> in.						1 Steel	3 RMP (SR)	5 Wrought	7 Fiberglass	9 Other (Specify below)	<input checked="" type="checkbox"/> PVC	4 ABS	6 Asbestos-Cement	8 Concrete Tile														
1 Steel	3 RMP (SR)	5 Wrought	7 Fiberglass	9 Other (Specify below)																										
<input checked="" type="checkbox"/> PVC	4 ABS	6 Asbestos-Cement	8 Concrete Tile																										
6	GROUT PLUG MATERIAL: 1 Neat cement <input checked="" type="checkbox"/> Cement grout 3 Bentonite 4 Other Grout Plug Intervals: From <u>3</u> ft. to <u>28</u> ft., From ft. to ft., From to ft. What is the nearest source of possible contamination: <table style="width:100%; border: none;"> <tr> <td>1 Septic tank</td> <td>6 Seepage pit</td> <td>11 Fuel storage</td> <td>16 Other (specify below)</td> </tr> <tr> <td>2 Sewer lines</td> <td>7 Pit privy</td> <td>12 Fertilizer storage</td> <td><u>Open Field</u></td> </tr> <tr> <td>3 Watertight sewer lines</td> <td>8 Sewage lagoon</td> <td>13 Insecticide storage</td> <td></td> </tr> <tr> <td>4 Lateral lines</td> <td>9 Feedyard</td> <td>14 Abandoned water well</td> <td></td> </tr> <tr> <td>5 Cess Pool</td> <td>10 Livestock pens</td> <td>15 Oil well/Gas well</td> <td></td> </tr> </table> Direction from well? How many feet?						1 Septic tank	6 Seepage pit	11 Fuel storage	16 Other (specify below)	2 Sewer lines	7 Pit privy	12 Fertilizer storage	<u>Open Field</u>	3 Watertight sewer lines	8 Sewage lagoon	13 Insecticide storage		4 Lateral lines	9 Feedyard	14 Abandoned water well		5 Cess Pool	10 Livestock pens	15 Oil well/Gas well					
1 Septic tank	6 Seepage pit	11 Fuel storage	16 Other (specify below)																											
2 Sewer lines	7 Pit privy	12 Fertilizer storage	<u>Open Field</u>																											
3 Watertight sewer lines	8 Sewage lagoon	13 Insecticide storage																												
4 Lateral lines	9 Feedyard	14 Abandoned water well																												
5 Cess Pool	10 Livestock pens	15 Oil well/Gas well																												
<table border="1" style="width:100%; border-collapse: collapse;"> <thead> <tr> <th style="width:10%;">FROM</th> <th style="width:10%;">TO</th> <th style="width:80%;">PLUGGING MATERIALS</th> </tr> </thead> <tbody> <tr> <td><u>0</u></td> <td><u>3</u></td> <td><u>Topsoil</u></td> </tr> <tr> <td><u>3</u></td> <td><u>28</u></td> <td><u>Cement</u></td> </tr> <tr> <td><u>28</u></td> <td><u>112</u></td> <td><u>Sand</u></td> </tr> <tr><td> </td><td> </td><td> </td></tr> <tr><td> </td><td> </td><td> </td></tr> <tr><td> </td><td> </td><td> </td></tr> <tr><td> </td><td> </td><td> </td></tr> </tbody> </table>							FROM	TO	PLUGGING MATERIALS	<u>0</u>	<u>3</u>	<u>Topsoil</u>	<u>3</u>	<u>28</u>	<u>Cement</u>	<u>28</u>	<u>112</u>	<u>Sand</u>												
FROM	TO	PLUGGING MATERIALS																												
<u>0</u>	<u>3</u>	<u>Topsoil</u>																												
<u>3</u>	<u>28</u>	<u>Cement</u>																												
<u>28</u>	<u>112</u>	<u>Sand</u>																												
7	CONTRACTOR'S OR LANDOWNER'S CERTIFICATION: This water well was plugged under my jurisdiction and was completed on (mo/day/year) <u>10-11-02</u> and this record is true to the best of my knowledge and belief. Kansas Water Well Contractor's License No. <u>238</u> This Water Well Record was completed on (mo/day/year) <u>10-21-02</u> under the business name of <u>Weninger Irrigation</u> by (signature) <u>Conrad Weninger</u>																													

INSTRUCTIONS: Use typewriter or ball point pen. Please press firmly and print clearly. Please fill in blanks, underline or circle the correct answers. Send top three copies to Kansas Department of Health and Environment, Bureau of Water, Topeka, Kansas 66620-0001. Telephone: 785/296-3565. Send one to Water Well Owner and retain one for your records.