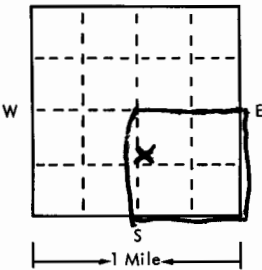
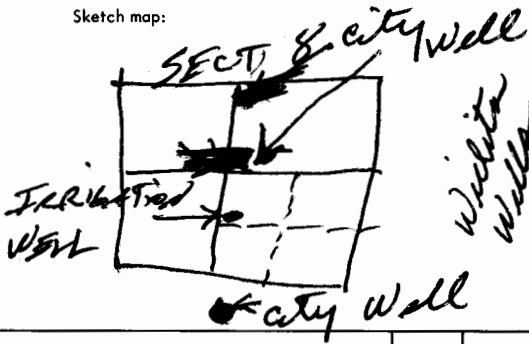


USE TYPEWRITER OR BALL
POINT PEN-PRESS FIRMLY,
PRINT CLEARLY.

WATER WELL RECORD
KSA 82a-1201-1215

T R EW sec 1/4 1/4 1/4 No.

Kansas State Dept. Of Health
(Water Well Contractors)
Forbes-Bldg. 740
Topeka, Kansas 66620

1 Location of well:	County HARVEY	Township name LAKIN	Fraction SE 1/4	Section number 8	Town number T24S	Range number Q-W			
Distance and direction from nearest town or city: 3 1/2 S.W. of HALSTEAD, KS			3 Owner of well: JESSIE KOEHN Address: RR HALSTEAD, KANSAS						
Locate with "X" in section below: 		Sketch map: 		4 Well depth: 232 ft. Date of completion 9-9-75 Well diameter: 30 in.					
2		Type and color of material		From		To		5 <input type="checkbox"/> Cable tool <input checked="" type="checkbox"/> Rotary <input type="checkbox"/> Driven <input type="checkbox"/> Dug <input type="checkbox"/> Hollow rod <input type="checkbox"/> Jetted <input type="checkbox"/> Bored <input checked="" type="checkbox"/> Reverse rotary	
								6 Use: <input type="checkbox"/> Domestic <input type="checkbox"/> Public supply <input type="checkbox"/> Industry <input checked="" type="checkbox"/> Irrigation <input type="checkbox"/> Air conditioning <input type="checkbox"/> Commercial <input type="checkbox"/> Test well	
								7 Casing: Material TRANSITE Height: above 2 ft. Threaded <input type="checkbox"/> Welded <input type="checkbox"/> Surface 2 ft. Diam. 16 in. to 232 ft. depth Weight 16 lbs./ft. Drive shoe? <input type="checkbox"/> Yes <input type="checkbox"/> No	
								8 Screen: Manufacturer JOHN MANSFIELD Type TRANSITE Dia. 16 in. 1/2 Slot/gauze 1/8 Length 52 ft. Set between 54 ft. and 180 ft. Fittings: 206 - 232 Gravel pack <input checked="" type="checkbox"/> Yes <input type="checkbox"/> No Size range of material 1/4	
								9 Static water level: 42 ft. below land surface Date 9-9-75	
								10 Pumping level below land surfaces: ____ ft. after ____ hrs. pumping ____ g.p.m. ____ ft. after ____ hrs. pumping ____ g.p.m. Estimated maximum yield 1500 g.p.m.	
								11 Water sample submitted: <input type="checkbox"/> Yes <input checked="" type="checkbox"/> No Date ____	
								12 Well head completion: <input type="checkbox"/> Pitless adapter <input type="checkbox"/> Inches above grade	
								13 Well grouted? <input checked="" type="checkbox"/> Yes <input type="checkbox"/> No <input type="checkbox"/> Neat cement <input type="checkbox"/> Bentonite <input checked="" type="checkbox"/> Clay Depth: From 0 ft. to 15 ft.	
								14 Nearest source of possible contamination: ft. 1/2 mile Direction EAST Type Well Well disinfected upon completion? <input type="checkbox"/> Yes <input checked="" type="checkbox"/> No	
								15 Pump: <input type="checkbox"/> Not installed Manufacturer's name WESTERN LAND ROVER Model number 8m HP 50 Volts Length of drop pipe 120 ft. capacity 1400 g.p.m. Type: <input type="checkbox"/> Submersible <input checked="" type="checkbox"/> Turbine <input type="checkbox"/> Jet <input type="checkbox"/> Reciprocating <input type="checkbox"/> Centrifugal <input type="checkbox"/> Other	
								16 Remarks: elevation FLAT LAND Topography: <input type="checkbox"/> Hill <input type="checkbox"/> Slope <input type="checkbox"/> Upland <input type="checkbox"/> Valley	
								17 Water well contractor's certification: This well was drilled under my jurisdiction and this report is true to the best of my knowledge and belief. PETERSON BROS INC 138 Business name License No. Address LINDSAY, KANS Signed Valley Peterson Date 9-10-75 Authorized representative	