

MW60
MW65

1 LOCATION OF WATER WELL:	Fraction	Section Number	Township Number	Range Number
County: HARVEY	NW 1/4 NE 1/4 SW 1/4	34	T 24 S	R 1W E/W

Distance and direction from nearest town or city street address of well if located within city?

Southwest corner of Tth Jackson - Sedgewick


2 WATER WELL OWNER: Andak Farmstead Coop

RR#, St. Address, Box # :
City, State, ZIP Code :

304 E 4TH
Sedgewick KS

Board of Agriculture, Division of Water Resources
Application Number: 67135

3 LOCATE WELL'S LOCATION WITH AN "X" IN SECTION BOX: 4 DEPTH OF COMPLETED WELL 44 ft. ELEVATION: 67135

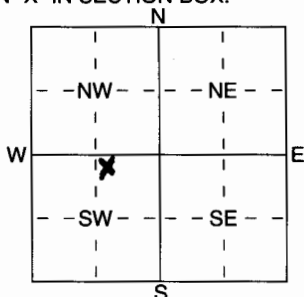

Depth(s) Groundwater Encountered 1 ft. 2 ft. 3 ft.
WELL'S STATIC WATER LEVEL 23.68 ft. below land surface measured on mo/day/yr
Pump test data: Well water was 8/1.5 gpm: Well water was 8/1.5 gpm
Est. Yield 8/1.5 gpm: Well water was 8/1.5 gpm
WELL WATER TO BE USED AS: 5 Public water supply 8 Air conditioning 11 Injection well
1 Domestic 3 Feedlot 6 Oil field water supply 9 Dewatering 12 Other (Specify below)
2 Irrigation 4 Industrial 7 Domestic (lawn & garden) 10 Monitoring well

Was a chemical/bacteriological sample submitted to Department? Yes No; If yes, mo/day/yr sample was submitted Water Well Disinfected? Yes No

5 TYPE OF BLANK CASING USED: 5 Wrought iron 8 Concrete tile CASING JOINTS: Glued Clamped

1 Steel 3 RMP (SR) 6 Asbestos-Cement 9 Other (specify below) Welded
2 PVC 4 ABS 7 Fiberglass Threaded

Blank casing diameter 2 in. to 27 ft. Dia 2 in. to 39 (39) Dia
Casing height above land surface 34 in. weight lbs./ft. Wall thickness or gauge No. 40

TYPE OF SCREEN OR PERFORATION MATERIAL: 1 Steel 3 Stainless Steel 5 Fiberglass 8 RMP (SR) 10 Asbestos-Cement
2 Brass 4 Galvanized Steel 6 Concrete tile 9 ABS 11 Other (Specify) 12 None used (open hole)

SCREEN OR PERFORATION OPENINGS ARE: 1 Continuous slot 2 Louvered shutter 3 Mill slot 4 Key punched 5 Gauzed wrapped 6 Wire wrapped 7 Torch cut 8 Saw cut 9 Drilled holes 10 Other (specify) 11 None (open hole)

SCREEN-PERFORATED INTERVALS: From 39 ft. to 44 ft. From 27 ft. to 32 ft.
GRAVEL PACK INTERVALS: From 37.8 ft. to 46 ft. From 25 ft. to 32 ft.

6 GROUT MATERIAL: 1 Neat cement 2 Cement grout 3 Bentonite 4 Other
Grout Intervals: From 1 ft. to 25 ft. From 32 ft. to 37.8 ft. From 37.8 ft. to 44 ft.

What is the nearest source of possible contamination: 1 Septic tank 4 Lateral lines 7 Pit privy 10 Livestock pens 14 Abandoned water well
2 Sewer lines 5 Cess pool 8 Sewage lagoon 11 Fuel storage 15 Oil well/Gas well
3 Watertight sewer lines 6 Seepage pit 9 Feedyard 12 Fertilizer storage 16 Other (specify below)
Direction from well? SW Runoff from Tth Jackson

FROM	TO	LITHOLOGIC LOG	FROM	TO	PLUGGING INTERVALS
0	17	Silt, clay - brown to tan w/ sand from 12'	0	1	Cement cap
17	32	Sand/gravel w/ some clay	1	25	3/8 BENTONITE COILS
32	35	Sand w/ gray clay	25	32	10/20 Sand
35	38	Gray clay	32	37.8	3/8 chips
38	44	Gray clay w/ sand + gravel green shale deep	37.8	44	10/20 Sand

RECEIVED

SEP 03 2004

BUREAU OF WATER

7 CONTRACTOR'S OR LANDOWNER'S CERTIFICATION: This water well was (1) constructed, (2) reconstructed, or (3) plugged under my jurisdiction and was completed on (mo/day/year) 5/12/04 and this record is true to the best of my knowledge and belief. Kansas Water Well Contractor's Licence No 465 This Water Well Record was completed on (mo/day/yr) 8/4/04 under the business name of Pratt Well Environmental by (signature) Shawn Egan