

**CORRECTION(S) TO WATER WELL RECORD (WWC-5)**

(to rectify lacking or incorrect information)

Location listed as:

Section-Township-Range: 34-245-1W

Fraction (  $\frac{1}{4}$   $\frac{1}{4}$   $\frac{1}{4}$ ): SE NE SE

County: Harvey

Location changed to:

34-245-1W

NE NE SE

Other changes: Initial statements: Sedgwick County

Changed to: Harvey County

Comments: \_\_\_\_\_

verification method: wellsite address, city street map, and mapping tool & aerial photos on KGS website.

initials: DRF date: 6/8/2012

submitted by: Kansas Geological Survey, Data Resources Library, 1930 Constant Ave., Lawrence, KS 66047-3726

to: Kansas Dept of Health & Environment, Bureau of Water, 1000 SW Jackson, Suite 420, Topeka, KS 66612-1367.

## WATER WELL RECORD

## Form WWC-5

Division of Water Resources App. No.  

## 1 LOCATION OF WATER WELL:

County: Sedgwick

Fraction

 $\frac{1}{4}$  SE  $\frac{1}{4}$  NE  $\frac{1}{4}$  SE  $\frac{1}{4}$ 

Section Number

34

Township No.

T 24 S

Range Number

R 1 ☐ E ☒ WStreet/Rural Address of Well Location; if unknown, distance & direction from nearest town or intersection: If at owner's address, check here ☒.

## Global Positioning System (GPS) information:

Latitude: ..... (in decimal degrees)

Longitude: ..... (in decimal degrees)

Elevation: .....

Datum: ☐ WGS 84, ☐ NAD 83, ☐ NAD 27


## Collection Method:

☐ GPS unit (Make/Model: .....☐ Digital Map/Photo, ☐ Topographic Map, ☐ Land SurveyEst. Accuracy: ☐ <3 m, ☐ 3-5 m, ☐ 5-15 m, ☐ >15 m

## 2 WATER WELL OWNER:

RR#, Street Address, Box #: DICK ATWILL  
620 AUSTIN LNCity, State, ZIP Code : Sedgwick KS

## 3 LOCATE WELL WITH AN "X" IN SECTION BOX:

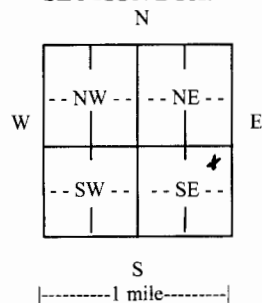

## 4 DEPTH OF COMPLETED WELL

100

ft.

Depth(s) Groundwater Encountered (1)..... ft. (2)..... ft. (3)..... ft.

WELL'S STATIC WATER LEVEL..... 21..... ft. below land surface measured on mo/day/yr.....

Pump test data: Well water was..... ft. after..... hours pumping..... gpm

EST. YIELD..... gpm. Well water was..... ft. after..... hours pumping..... gpm

Bore Hole Diameter ..... 1.2..... in. to ..... ft., and ..... in. to ..... ft.WELL WATER TO BE USED AS: ☐ Public water supply ☐ Geothermal ☐ Injection well☐ Domestic ☐ Feedlot ☐ Oil field water supply ☐ Dewatering ☐ Other (Specify below)☐ Irrigation ☐ Industrial ☒ Domestic-lawn & garden ☐ Monitoring well .....Was a chemical/bacteriological sample submitted to Department? ☐ Yes ☒ No

If yes, mo/day/yr sample was submitted.....

Water well disinfected? ☒ Yes ☐ No

## 5 TYPE OF CASING USED:

☐ Steel ☒ PVC ☐ Other .....CASING JOINTS: ☒ Glued ☐ Clamped ☐ Welded ☐ ThreadedCasing diameter ..... 5..... in. to ..... 100..... ft., Diameter ..... in. to ..... ft., Diameter ..... in. to ..... ft.Casing height above land surface..... 16..... in., Weight ..... 160..... lbs./ft., Wall thickness or gauge No. .... 20.....

## TYPE OF SCREEN OR PERFORATION MATERIAL:

☐ Steel ☐ Stainless Steel ☒ PVC☐ Brass ☐ Galvanized Steel ☐ None used (open hole)☐ Other (Specify) .....

## SCREEN OR PERFORATION OPENINGS ARE:

☐ Continuous slot ☒ Mill slot ☐ Gauze wrapped ☐ Torch cut ☐ Drilled holes ☐ None (open hole)☐ Louvered shutter ☐ Key punched ☐ Wire wrapped ☐ Saw cut ☐ Other (specify) .....

SCREEN-PERFORATED INTERVALS: From..... ft. to ..... ft., From..... ft. to ..... ft.

From..... ft. to ..... ft., From..... ft. to ..... ft.

GRAVEL PACK INTERVALS: From..... ft. to ..... ft., From..... ft. to ..... ft.

From..... ft. to ..... ft., From..... ft. to ..... ft.

## 6 GROUT MATERIAL:

☐ Neat cement ☐ Cement grout ☒ Bentonite ☐ Other .....Grout Intervals: From ..... 4..... ft. to ..... 34..... ft., From..... ft. to ..... ft., From..... ft. to ..... ft.

What is the nearest source of possible contamination:

☐ Septic tank ☐ Lateral lines ☐ Pit privy ☐ Livestock pens ☐ Insecticide storage ☐ Other (specify below)☐ Sewer lines ☐ Cesspool ☐ Sewage lagoon ☐ Fuel storage ☐ Abandoned water well☒ Watertight sewer lines ☐ Seepage pit ☐ Feedyard ☐ Fertilizer storage ☐ Oil well/gas well .....Direction from well ..... East..... Distance from well ..... 90'.....

FROM TO LITHOLOGIC LOG FROM TO LITHO. LOG (cont.) or PLUGGING INTERVALS

FROM	TO	LITHOLOGIC LOG
0	2	Top Soil
2	19	Clay
19	37	med Sand
37	100	Shale

7 CONTRACTOR'S OR LANDOWNER'S CERTIFICATION: This water well was ☒ constructed, ☐ reconstructed, or ☐ pluggedunder my jurisdiction and was completed on (mo/day/year) ..... 4-11-12..... and this record is true to the best of my knowledge and belief.Kansas Water Well Contractor's License No. .... 62..... This Water Well Record was completed on (mo/day/year) ..... 4-18-12.....under the business name of ..... Chase Drilling..... by (signature) ..... [Signature].....

INSTRUCTIONS: Use typewriter or ball point pen. PLEASE PRESS FIRMLY and PRINT clearly. Please fill in blanks and check the correct answers. Send three copies (white, blue, pink) to Kansas Department of Health and Environment, Bureau of Water, Geology Section, 1000 SW Jackson St., Suite 420, Topeka, Kansas 66612-1367. Telephone 785-296-5524. Send one copy to WATER WELL OWNER and retain one for your records. Include fee of \$5.00 for each constructed well. Visit us at <http://www.kdheks.gov/waterwell/index.html>.