

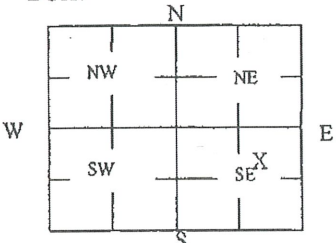
WATER WELL PLUGGING RECORD Form WWC-5P

KSA 82a-1212

ID NO.

48083

1 LOCATION OF WATER WELL: County: Harvey	Fraction 1/4 SW 1/4 NE 1/4 SE 1/4	Section Number 33	Township Number T 24 S	Range Number 1 <input type="checkbox"/> E <input checked="" type="checkbox"/> W
Street/Rural Address of Well Location; if unknown, distance & direction from nearest town or intersection: If at owner's address, check here <input checked="" type="checkbox"/> 400 W. 4th St., Sedgwick, KS 67135		Global Positioning Systems (GPS) information: Latitude: 37.91713 (in decimal degrees) Longitude: -97.43037 (in decimal degrees) Elevation: Horizontal Datum: <input type="checkbox"/> WGS84, <input checked="" type="checkbox"/> NAD83, <input type="checkbox"/> NAD27 Collection Method: <input checked="" type="checkbox"/> GPS unit (Make/Model: Garmin GPSmap60CSx) <input type="checkbox"/> Digital Map/Photo, <input type="checkbox"/> Topographic Map, <input type="checkbox"/> Land Survey Est. Accuracy: <input type="checkbox"/> < 3 m, <input checked="" type="checkbox"/> 3-5 m, <input type="checkbox"/> 5-15 m, <input type="checkbox"/> > 15 m		
2 WATER WELL OWNER: Sedgwick Publ. Schs, USD 439 RR#, St. Address, Box #: P.O. Box K, 400 W. 4th St. City, State ZIP Code: Sedgwick, KS 67135				

3 MARK WELL'S LOCATION WITH AN "X" IN SECTION BOX: 	4 DEPTH OF WELL Est: 125 ft. WELL'S STATIC WATER LEVEL 24.3 ft. WELL WAS USED AS: <input checked="" type="checkbox"/> Domestic <input type="checkbox"/> Public Water Supply <input type="checkbox"/> Dewatering <input type="checkbox"/> Irrigation <input type="checkbox"/> Oil Field Water Supply <input type="checkbox"/> Monitoring <input type="checkbox"/> Feedlot <input type="checkbox"/> Domestic (Lawn & Garden) <input type="checkbox"/> Injection Well <input type="checkbox"/> Industrial <input type="checkbox"/> Air Conditioning <input type="checkbox"/> Other _____ Was a chemical/bacteriological sample submitted to Department? Yes <input type="checkbox"/> No <input checked="" type="checkbox"/>
---	---

5 TYPE OF BLANK CASING USED:
☒ Steel ☐ RMP (SR) ☐ Wrought ☐ Fiberglass ☐ Other (Specify below)
☐ PVC ☐ ABS ☐ Asbestos-Cement ☐ Concrete Tile
 Blank casing diameter 12 in. Was casing pulled? Yes ☐ No ☒ If yes, how much _____
 Casing height above or below land surface below 36 in.

6 GROUT PLUG MATERIAL: ☐ Neat cement ☒ Cement grout ☐ Bentonite ☐ Other _____
 Grout Plug Intervals: From 24.3 ft. to 3 ft., From _____ ft. to _____ ft., From _____ ft. to _____ ft.
 What is the nearest source of possible contamination:
☐ Septic tank ☐ Seepage pit ☐ Fuel storage ☐ Other (specify below)
☐ Sewer lines ☐ Pit privy ☐ Fertilizer storage
☒ Watertight sewer lines ☐ Sewage lagoon ☐ Insecticide storage
☐ Lateral lines ☐ Feedyard ☐ Abandoned water well Direction from well? north
☐ Cess pool ☐ Livestock pens ☐ Oil well/Gas well How many feet? approximately 100 ft.

FROM	TO	PLUGGING MATERIALS	FROM	TO	PLUGGING MATERIALS
Est: 125'	93.7'	Formation Sand (casing collapsed)			
93.7'	24.3'	Clean, coarse sand			10" pvc liner inside 12" steel well
24.3'	3'	Cement grout			casing
3'	0'	Topsoil			

7 CONTRACTOR'S OR LANDOWNER'S CERTIFICATION: This water well was plugged under my jurisdiction and was completed on (mo/day/year) 7/31/2023 and this record is true to the best of my knowledge and belief. Kansas Water Well Contractor's License No. _____ This Water Well Record was completed on (mo/day/year) 8/22/2023 under the business name of USD 439 Sedgwick Public Schools by (signature) Mr. Rae Hulen

Send one white copy to Kansas Department of Health & Environment, Geology Section, 1000 SW Jackson Street, Ste. 420, Topeka, KS 66612-1367. Send one copy to WATER WELL OWNER and retain one for your records.

RECEIVED

Visit us at <http://www.kdheks.gov/waterwell/index.html>

Telephone 785-296-5524.

RECEIVED

SEP 05 2023

KSA82a-1212

Revised 1/20/2015