


1 LOCATION OF WATER WELL:	Fraction	Section Number	Township Number	Range Number
County: Reno	NE ¼ NE ¼ SW ¼	15	T 24 S	R 10 EW

Distance and direction from nearest town or city street address of well if located within city?

811 Main, Sylvia, Kansas

2	WATER WELL OWNER:	Sylvia COOP	
	RR#, St. Address, Box #	811 Main	Board of Agriculture, Division of Water Resources
	City, State, ZIP Code	Sylvia, Kansas 67581	Application Number:

3 LOCATE WELL'S LOCATION
WITH AN "X" IN SECTION BOX:
N

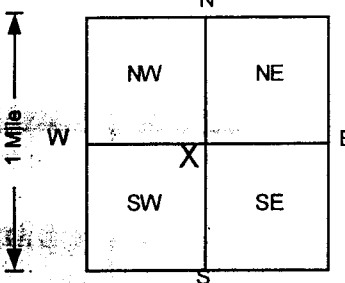

4) DEPTH OF COMPLETED WELL 24 ft. ELEVATION: 0

Depth(s) Groundwater Encountered 1 16 ft. 2 ft. 3 ft.

WELL'S STATIC WATER LEVEL ft. below land surface measured on mo/day/yr

Pump test data: Well water was NA ft. after hours pumping gpm

Est. Yield NA gpm: Well water was ft. after hours pumping gpm

Bore Hole Diameter 8 in. to 24 ft., and in. to ft.

WELL WATER TO BE USED AS:

5 Public water supply	8 Air conditioning	11 Injection well		
1 Domestic	3 Feedlot	6 Oil field water supply	9 Dewatering	12 Other (Specify below)
2 Irrigation	4 Industrial	7 Lawn and garden only	10 Monitoring well	

Was a chemical/bacteriological sample submitted to Department? Yes.....No✓.....; If yes, mo/day/yr sample was submitted

Water Well Disinfected? Yes No✓

5 TYPE OF BLANK CASING USED:

1 Steel	3 RMP (SR)	5 Wrought iron	8 Concrete tile	CASING JOINTS: Glued Clamped
2 PVC	4 ABS	6 Asbestos-Cement	9 Other (specify below)	Welded
		7 Fiberglass		Threaded. ☒

Blank casing diameter 2 in. to 22 ft., Dia in. to ft., Dia in. to ft.

Casing height above land surface 20847 in., weight lbs./ft. Wall thickness or gauge No. Sch. 40

TYPE OF SCREEN OR PERFORATION MATERIAL

1 Steel	3 Stainless steel	5 Fiberglass	7 PVC	10 Asbestos-cement
2 Brass	4 Galvanized steel	6 Concrete tile	8 RMP (SR)	11 Other (specify)
			9 ABS	12 None used (open hole)

SCREEN OR PERFORATION OPENINGS ARE:

1 Continuous slot	3 Mill slot	5 Gauzed wrapped	8 Saw cut	11 None (open hole)
2 Louvered shutter	4 Key punched	6 Wire wrapped	9 Drilled holes	
		7 Torch cut	10 Other (specify)	

SCREEN-PERFORATED INTERVALS: From 22 ft. to 24 ft., From ft. to ft., From ft. to ft.

GRAVEL PACK INTERVALS: From 20 ft. to 24 ft., From ft. to ft., From ft. to ft.

6 GROUT MATERIAL: 1 Neat cement 2 Cement grout 3 Bentonite 4 Other
Grout Intervals: From . . . 0 . . . ft to . . . 2 . . . ft, From . . . 2 . . . ft to . . . 20 . . . ft, From ft to ft
What is the nearest source of possible contamination:
1 Septic tank 4 Lateral lines 7 Pit privy 10 Livestock pens 14 Abandoned water well
2 Sewer lines 5 Cess pool 8 Sewage lagoon 11 Fuel storage 15 Oil well/Gas well
3 Watertight sewer lines 6 Seepage pit 9 Feedyard 12 Fertilizer storage 16 Other (specify below)
Direction from well? W 13 Insecticide storage AST
How many feet? 75

FROM	TO	LITHOLOGIC LOG	FROM	TO	PLUGGING INTERVALS
0	1	Sand and Gravel (fill),			
1	13	Sand, Brown			
13	16	Sand, Light Gray Brown			
16	21	Sand, Light Gray			
21	24	Sand, Light Brown			
					IW6R , Tag # 00355793 , Flushmount
					Project Name: Greenfield - Sylvia Coop
					GeoCore # 897 , KDHE # A2 078 40106

7 CONTRACTOR'S OR LANDOWNER'S CERTIFICATION: This water well was (1) constructed, (2) reconstructed, or (3) plugged under my jurisdiction and was completed on (mo/day/year) 9/10/02 and this record is true to the best of my knowledge and belief.
Kansas Water Well Contractor's License No. 527 This Water Well Record was completed on (mo/day/yr) 10/30/02
under the business name of GeoCore Inc. by (signature) Dale Bell