


2	WATER WELL OWNER:	Sylvia COOP	
	RR#, St. Address, Box #	811 Main	Board of Agriculture, Division of Water Resources
	City, State, ZIP Code	Sylvia, Kansas 67581	Application Number:

4 DEPTH OF COMPLETED WELL	25	ft.	ELEVATION:	1737.29			
Depth(s) Groundwater Encountered	1.	16.	ft.	2.	ft.	3.	ft.

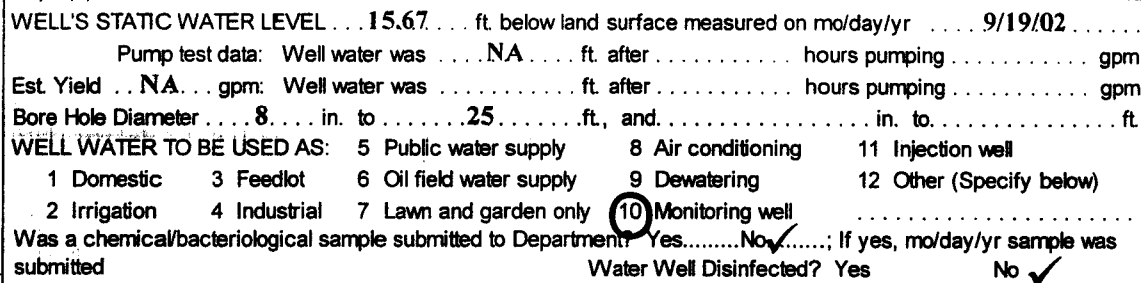

Casing height above land surface . . . -8.16 . . . in., weight . . . lbs./ft. Wall thickness or gauge No. . . . Sch. 40 . . .

TYPE OF SCREEN OR PERFORATION MATERIAL

7 PVC

10 Asbestos-cement

SCREEN OR PERFORATION OPENINGS ARE:

1 Continuous slot	3 Mill slot	5 Gauzed wrapped	8 Saw cut	11 None (open hole)
		6 Wire wrapped	9 Drilled holes	

GRAVEL PACK INTERVALS: From 4 ft to 25 ft, From ft to ft

Grout Intervals: From 0 ft to 1 ft, From 1 ft to 4 ft, From ft to ft.

What is the nearest source of possible contamination: 10 Livestock pens 14 Abandoned water well

1 Septic tank	4 Lateral lines	7 Pit privy	11 Fuel storage	15 Oil well/Gas well
2 Sewer lines	5 Cess pool	8 Sewage lagoon	12 Fertilizer storage	16 Other (specify below)
3 Watertight sewer lines	6 Seepage pit	9 Feedyard	13 Insecticide storage	AST

Direction from well?		NE	How many feet? 400		
FROM	TO	LITHOLOGIC LOG	FROM	TO	PLUGGING INTERVALS
0	2.5	Sand, Brown			
2.5	8	Sand, Red Brown			
8	12	Clay, Light Gray Brown			
12	16	Sand, Light Brown			
16	21	Sand, Brown			
21	25	Sand, Brown			
					MW11R , Tag # 00355809 , Flushmount
					Project Name: Greenfield - Sylvia Coop
					GeoCore # 897 , KDHE # A2 078 40106

CONTRACTOR'S OR LANDOWNER'S CERTIFICATION: This water well was (1) constructed, (2) reconstructed, or (3) plugged under my jurisdiction and was completed on (mo/day/year) 9/6/02 and this record is true to the best of my knowledge and belief.
Kansas Water Well Contractor's License No. 527 This Water Well Record was completed on (mo/day/yr) 10/30/02
under the business name of GeoCore Inc. by (signature) *GeoCore Inc.*